


WELL PLUGGING RECORD

Give All Information Completely
Make Required Affidavit
Mail or Deliver Report to:
Conservation Division
State Corporation Commission
211 No. Broadway
Wichita, Kansas

Meade County, Sec. 16 Twp. 34 Rgc. 29 (E) (W)

NORTH

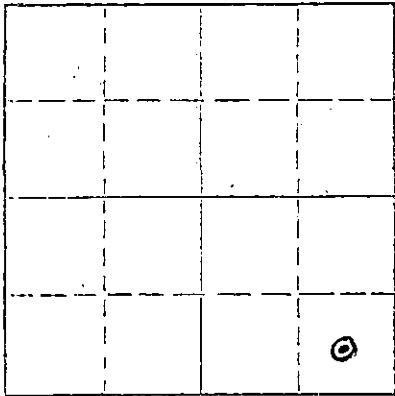

Locate well correctly on above
Section Plat

Location as "NE/CNW&SW&" or footage from lines C-SE-SE
Lease Owner Shenandoah Oil Co.
Lease Name H. G. Adams Well No. 1
Office Address 19 East 11th, Liberal, Kansas 67901
Character of Well (completed as Oil, Gas or Dry Hole) Gas
Date well completed January 21 1966
Application for plugging filed 7-27 1970
Application for plugging approved 7-30 1970
Plugging commenced 9/9/ 1970
Plugging completed 9/10/ 1970
Reason for abandonment of well or producing formation Production not Commercial

If a producing well is abandoned, date of last production August 1 1970
Was permission obtained from the Conservation Division or its agents before plugging was commenced? yes

Name of Conservation Agent who supervised plugging of this well Ed Eves, Sublett, Ks.
Producing formation Council Grove Depth to top 3253 Bottom 3296 Total Depth of Well 3320 Feet
Show depth and thickness of all water, oil and gas formations.

OIL, GAS OR WATER RECORDS CASING RECORD

FORMATION	CONTENT	FROM	TO	SIZE	PUT IN	PULLED OUT
				8 5/8"	612'	-0-
	STATE CORPORATION COMMISSION			2 7/8"	3315'	2500'
	CONSERVATION DIVISION					
	Wichita, Kansas					

Describe in detail the manner in which the well was plugged, indicating where the mud fluid was placed and the method or methods used in introducing it into the hole. If cement or other plugs were used, state the character of same and depth placed, from _____ feet to _____ feet for each plug set.

Mix 5 sks. cement w/ hulls and stop plug at 3,100'. Heavy mud to 600'
Pump 35 sks. cement at 600' to 500', heavy mud to 40'
Put 10 sks. cement at 40' to 0'.

(If additional description is necessary, use BACK of this sheet)

Name of Plugging Contractor Sargent's Casing Pulling Service
Address 121 W. 9th St., Liberal, Kansas 67901

STATE OF Kansas, COUNTY OF Seward, ss.
Harold L. Young (employee of owner) or (~~owner or operator~~) of the above-described well, being first duly sworn on oath, says: That I have knowledge of the facts, statements, and matters herein contained and the log of the above-described well as filed and that the same are true and correct. So help me God.

(Signature) Harold L. Young
Box 1387 Liberal Kansas 67901 (Address)

Subscribed and sworn to before me this 25 day of September, 1970



Larissa Johns
Notary Public.

LEASE: H. G. Adams No. 1
 OWNER: Shenandoah Oil Corporation
 CONTRACTOR: Moran Bros.
 COMMENCED: 2:00 A.M. 12-27-65
 COMPLETED: 4:15 P.M. 1- 3-66

LOCATION: C SE-SE Section 16,
 T34S, R29W,
 Meade County, Kansas
 CASING: 8-5/8" set @ 612'

Sand & shale	300'
Sand & Red Bed	612'
Red Bed, shale & sand	995'
Shale, gyp and anhydrite	1500'
Shale	1775'
Shale and anhydrite	2070'
Anhydrite and shale	2260'
Broken lime & shale	2460'
Lime	2560'
Lime and shale	2658'
Shale and lime	2700'
Dolomite, lime and shale	2805'
Dolomite and lime	2868'
Dolomite and lime	2975'
Lime and dolomite streaks	3041'
Lime and dolomite	3083'
Shale and lime	3260'
Lime	3283'
Lime w/shale streaks	3320' T.D.

RECEIVED
 STATE CORPORATION COMMISSION
 OCT 19 1970
 CONSERVATION DIVISION
 Wichita, Kansas

STATE OF TEXAS

COUNTY OF TARRANT

I, Harold E. Burke, do hereby certify that the above is a true and correct copy of the drilling log on the H. G. Adams Well No. 1, located in C SE-SE, Section 16, T34S, R29W, Meade County, Kansas.

SHENANDOAH OIL CORPORATION

Harold E. Burke
 Harold E. Burke

Subscribed and sworn to before me this 27th day of January
 1966.

My Commission Expires:

June 1, 1969

Mary A. Samuel