


STATE OF KANSAS
STATE CORPORATION COMMISSION

WELL PLUGGING RECORD

Give All Information Completely
Make Required Affidavit
Mail or Deliver Report to
Conservation Division
State Corporation Comm.
245 North Water
Wichita, KS 67202

Meade County, Sec. 14 Twp. 34S Rge. 29 ~~E~~/W
Location as "NE/CNW $\frac{1}{4}$ SW $\frac{1}{4}$ " or footage from lines
C NE SW
Lease Owner Texaco Inc.
Lease Name H. G. Adams "G" Well No. 1
Office Address Box 2420, Tulsa, OK 74102
Character of Well (Completed as Oil, Gas or Dry Hole)

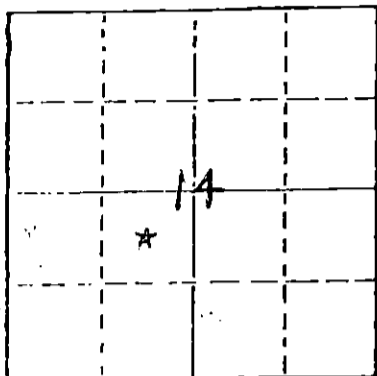

Locate well correctly on above
Section Plot

Gas
Date Well completed 1/9 1961
Application for plugging filed 4/27 1978
Application for plugging approved 5/1 1978
Plugging commenced 5/15 1978
Plugging completed 5/16 1978
Reason for abandonment of well or producing formation
Not economical
If a producing well is abandoned, date of last production
N/A 19

Was permission obtained from the Conservation Division or
its agents before plugging was commenced? Yes

Name of Conservation Agent who supervised plugging of this well Clarence Thomas
Producing formation _____ Depth to top _____ Bottom _____ Total Depth of Well _____
Show depth and thickness of all water, oil and gas formations.

OIL, GAS OR WATER RECORDS

CASING RECORD

FORMATION	CONTENT	FROM	TO	SIZE	PUT IN	PULLED OUT

Describe in detail the manner in which the well was plugged, indicating where the mud fluid
was placed and the method or methods used in introducing it into the hold. If cement or other
plugs were used, state the character of same and depth placed, from _____ feet to
_____ feet for each plug set.

Well plugged as follows:

- From 3268-3000' w/10 sx cmt, 3000-450' w/hvy mud,
- 450-350' w/50 sx cmt, 350-40' w/hvy mud &
- 40' to 3' below G.L. w/10 sx cmt.

RECEIVED
STATE CORPORATION COMMISSION
JUN 05 1978
CONSERVATION DIVISION

(If additional description is necessary, use BACK of this sheet)

Name of Plugging Contractor Sargent's Casing Pulling Service

STATE OF OKLAHOMA COUNTY OF TULSA, ss.
H. D. Zimmerman (employee of owner)

of the above-described well, being first duly sworn on oath, says: That I have knowledge of
the facts, statements, and matters herein contained and the log of the above-described well
as filed and that the same are true and correct. So help me God.

(Signature) H. D. Zimmerman
Box 2420, Tulsa, OK 74102
(Address)

SUBSCRIBED AND SWORN TO before me this 31st day of May, 1978

My commission expires July 21, 1979

Elizabeth A. Legg
Notary Public.

ROTARY DRILLING LOG

OPERATOR: Texaco, Inc.
H. G. Adams "C" #1
C NE SW Sec. 14-34-29W,
Meade County, Kansas

CONTRACTOR: Capitt Drilling, Inc.
CON: 12-23-60
COMP: 1-1-61

Remarks: Set 8-5/8" casing at 450'
cemented with 300 ex. Pozmix,
2% C.C.

Formations:

Sand & Shale	274'
Shale	450'
Red Bed & Shale	1034'
Shale & Lime	2000'
Lime & Anhydrite	2445'
Lime	3095'
Sandy Lime	3206'
Lime & Shale	3250'
Lime	3300'
Rotary Total Depth	3300'

Set 2-7/8" tubing at 3300.79' cemented
with 125 ex. Pozmix.

We certify the above log is true and
correct to the best of our knowledge
and belief.

CAPITT DRILLING, INC.

R. R. Mc Nicol

R. R. Mc Nicol

RECEIVED
STATE CORPORATION COMMISSION

MAY 01 1978

CONSERVATION DIVISION
Wichita, Kansas