


15-119-10324-0000

STATE OF KANSAS
STATE CORPORATION COMMISSION

WELL PLUGGING RECORD

Give All Information Completely
Make Required Affidavit
For Deliver Report to:
Conservation Division
State Corporation Commission
212 North Market, Insurance Bldg.
Wichita, Kansas

MEADE County. Sec. 13 Twp. 34S Rge. (#) 29 (W)

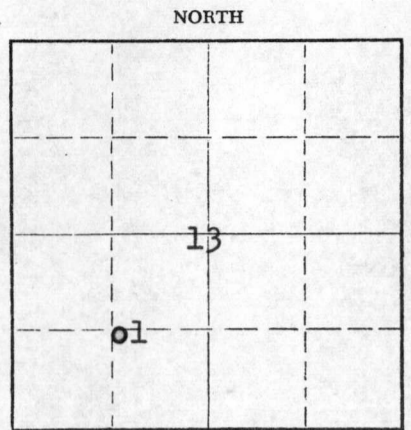

Locate well correctly on above Section Plat

Location as "NE/CNW/SW" or footage from lines Ctr SW/4
Lease Owner TEXACO INC.
Lease Name ADAMS-MERKLE Well No. 1
Office Address 614 Bitting Building - Wichita, Kansas
Character of Well (completed as Oil, Gas or Dry Hole) Dry
Date well completed 5-29- 1961
Application for plugging filed 6-7 1961
Application for plugging approved 6-1- 1961
Plugging commenced 6-2- 1961
Plugging completed 6-2- 1961
Reason for abandonment of well or producing formation Dry

If a producing well is abandoned, date of last production _____ 19____
Was permission obtained from the Conservation Division or its agents before plugging was commenced? Yes

Name of Conservation Agent who supervised plugging of this well Frank Broadfoot
Producing formation Council Grove lime Depth to top 3284 Bottom 3324 Total Depth of Well 3375 Feet
Show depth and thickness of all water, oil and gas formations.

OIL, GAS OR WATER RECORDS

CASING RECORD

FORMATION	CONTENT	FROM	TO	SIZE	PUT IN	PULLED OUT
Council Grove lime	Water	3284	3324	8-5/8"	263	None
				2-7/8"	3374	2510

Describe in detail the manner in which the well was plugged, indicating where the mud fluid was placed and the method or methods used in introducing it into the hole. If cement or other plugs were used, state the character of same and depth placed, from _____ feet to _____ feet for each plug set.
From 3341 to 3200 w/ cmt, 3200 to 250 w/hvy mud, 250 to 190 w/cmt, 190 to 40 w/mud, 40 to surface w/cmt.

RECEIVED
STATE CORPORATION COMMISSION

JUN 15 1961

CONSERVATION DIVISION
Wichita, Kansas

(If additional description is necessary, use BACK of this sheet)

Name of Plugging Contractor Company Tools
Address _____

STATE OF KANSAS, COUNTY OF SEDGWICK, ss.
M. C. HARRELL (employee of owner) or (owner or operator) of the above-described well, being first duly sworn on oath, says: That I have knowledge of the facts, statements, and matters herein contained and the log of the above-described well as filed and that the same are true and correct. So help me God.

(Signature) M. C. Harrell
614 Bitting Bldg. - Wichita, Kansas
(Address)

SUBSCRIBED AND SWORN TO before me this 8th day of JUNE, 1961

A. E. Boyd
Notary Public.

My commission expires June 20, 1964



Kp

LEASE: ADAMS-MERKLE UNIT #1
 OPERATOR: TEXACO INC
 CONTRACTOR: EARL F. WAKEFIELD
 COMM: 5/12/61 COMP: 5/22/61

LOCATION: C SW
 SECTION 13-34S-29W
 MEADE COUNTY, KANSAS
 CASING: 8 5/8" Set at 263'
 2 7/8" Set at 3375'

Sand and Red Bed	263
Sand	310
Shale and Red Bed	435
Red Bed	1080
Red Bed and Shale	1440
Shale and Shells	1855
Shale and Anhydrite	2035
Anhydrite and Shale	2205
Shale and Lime	2295
Lime and Shale	2628
Lime	3256
Lime and Chalk	3266
Lime	3375
T.D.	3375

STATE OF KANSAS)
)
 SEDGWICK COUNTY) SS

I hereby certify that the above is a true and correct copy of the log on the ADAMS-MERKLE UNIT #1, located C SW SECTION 13-34S-29W MEADE COUNTY, KANSAS.

EARL F. WAKEFIELD

By Fred S. Barber

Subscribed and sworn before me this 29th day of May, 1961

Wanda W. Riley
 WANDA W. RILEY NOTARY PUBLIC

My commission expires January, 25, 1965


RECEIVED
 OIL AND GAS CORPORATION COMMISSION

JUN 15 1961

CONSERVATION DIVISION
 Wichita, Kansas

TEXACO INC.—LOG OF WELL
TULSA DIVISION

640 ACRES
N

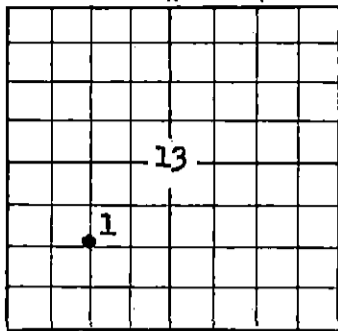

INDICATE EXACT WELL LOCATION & LEASE BOUNDARY WITHIN SECTION

WELL Adams-Merkle Unit #1 L. D. FILE NO. 121711
182139

LOC. Ctr. SW/4 SEC. 13 TWP. 34S RGE. 29W
1320 N & 1320 of SW Cor. of SW/4

DIST. Wichita CO.-PARISH Meade STATE Kansas

COMM. DRLG. 5-12-61 COMP. DRLG. 5-22-61 DAYS DRLG. 11

ROT. FROM 0 TO 3375 CABLE FROM - TO -

CONTR. OR CO. RIG NO. E. F. Wakefield T. D. DRILLED 3375

COMP. T. D. PB 3341 ZERO ELEV. KB 2518 GRD. ELEV. 2506.5 CSG. FLG. ELEV. 2506

DATE OF FIRST PROD. Dry Hole OFFICIAL COMP. DATE 5-30-61

LOGS RUN Radioactivity, Acoustic Velocity

CASING RECORD

SIZE INCHES	DEPTH FEET	WEIGHT #/FT.	GRADE	RANGE	REMARKS—QUAN. CMT., TEMP. SURV., ETC.
8-5/8	264	20#	J	2	Cmtd w/250 sx Poz, 2% Ca Cl. Cmt. Circ.
2-7/8	3374	6.5#	J	2	Cmtd w/100 sx Poz. 6-2-61 Pulled 2510'. KB-GL 11.70' GL-BH .30' 5 Centralizers fr 3220 to 3346 7 Scratchers fr 3275 to 3326

COMPLETION DATA

FORMATION	Dry Hole			
DATE OF TEST				
DEPTH OF PROD. INTERVAL				
INITIAL PRODUCTION:	OIL - BPD			
	GAS - MCF			
	WATER - BPD			
	GOR			
	BHP - PSI			
CORRECTED API GRAVITY				
PRODUCING CONDITIONS				
ARTIFICIAL STIMULATION				

REMARKS

RECEIVED
STATE CORPORATION COMMISSION

JUN 15 1961

CONSERVATION DIVISION
Wichita, Kansas

WELL Adams-Merkle #1 FIELD Horace So. AREA Liberal

GEOLOGICAL DATA AND DRILLING AND COMPLETION PROCEDURE

FORMATION OR DATE	TOP-DEPTH INTERVAL	REMARKS OR DESCRIPTION AND RESULTS OF WORK
5-21-61		<p style="text-align: center;"><u>REMARKS</u></p> <p>R/WLT #1 @ 3287'. Misrun.</p>
5-22-61		<p>R/WLT #2 @ 3287'. ISIP 0#, TO 1 hr., SP less than 100#, FSIP less than 100 #, NSO, G or W.</p>
5-26-61		<p>R/WLT #3 @ 3291'. ISIP 840#, TO 70", SP 0-820#, FSIP 850#. Rec. 207 CF free gas & 18,200 cc Wtr.</p>
		<p>MICT. R/Corr Log fr 2800-3341. Perf 3285-88 w/2 jets/ft, Tst Dry. Acidize w/500 Gal. 7-1/2%. Tst 6 BSWPH. Complete Dry.</p>
		<p style="text-align: center;"><u>LOG TOPS</u></p> <p>Wreford 2982 Council Grove 3036 Council Grove Pay 3284</p>
		<p style="text-align: center;">RECEIVED STATE CORPORATION COMMISSION JUN 15 1961 CONSERVATION DIVISION Wichita, Kansas</p>