

15-119-10266-0000

STATE OF KANSAS
STATE CORPORATION COMMISSION


Give All Information Completely
Make Required Affidavit
Mail or Deliver Report to:
Conservation Division
State Corporation Commission
11 No. Broadway
Wichita, Kansas

WELL PLUGGING RECORD

Meade County. Sec. 11 Twp. 34 Rge. (E) 29 (W)

Location as "NE/CNW/SW" or footage from lines Gen. S/2
Lease Owner Lario Oil & Gas Co.
Lease Name Adams Well No. 2
Office Address 301 S. Market, Wichita, Kansas
Character of Well (completed as Oil, Gas or Dry Hole) Dry Hole
Date well completed December 18 19 61
Application for plugging filed December 18 19 61
Application for plugging approved December 18 19 61
Plugging commenced December 18 19 61
Plugging completed December 18 19 61
Reason for abandonment of well or producing formation Dry Hole

NORTH

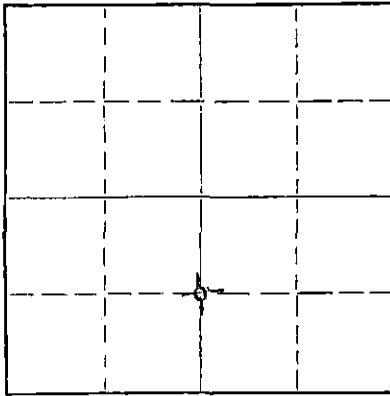

Locate well correctly on above
Section Plat

If a producing well is abandoned, date of last production _____ 19____
Was permission obtained from the Conservation Division or its agents before plugging was commenced? _____

Name of Conservation Agent who supervised plugging of this well Bill LeCamp
Producing formation _____ Depth to top _____ Bottom _____ Total Depth of Well 3270 Feet
Show depth and thickness of all water, oil and gas formations.

OIL, GAS OR WATER RECORDS

CASING RECORD

FORMATION	CONTENT	FROM	TO	SIZE	PUT IN	PULLED OUT
				8 5/8	450'	None Cem. 300 sx.

Describe in detail the manner in which the well was plugged, indicating where the mud fluid was placed and the method or methods used in introducing it into the hole. If cement or other plugs were used, state the character of same and depth placed, from _____ feet to _____ feet for each plug set.

Mud from T.D. to 440'. Set plug at 440' with 20 sacks cement to 60'. Mud to 35' set plug at 35' w/ 10 sacks cement to base of cellar.

STATE CORPORATION COMMISSION
12-21-61
DEC 21 1961

CONSERVATION DIVISION
Wichita, Kansas

(If additional description is necessary, use BACK of this sheet)

Name of Plugging Contractor Patton Drilling Co.
Address Wichita, Kansas

STATE OF Kansas, COUNTY OF Sedgwick, ss.
Leo Ross (employee of owner) or (owner or operator) of the above-described well, being first duly sworn on oath, says: That I have knowledge of the facts, statements, and matters herein contained and the log of the above-described well as filed and that the same are true and correct. So help me God.

(Signature) Leo Ross
(Address) _____

SUBSCRIBED AND SWORN TO before me this 20th day of December, 1961

My commission expires July 21, 1962
Francis Leslie Notary Public.

LARIO OIL & GAS COMPANY
H. G. Adams No. 2
Cen. S/2 Sec. 11-34S-29W
Meade County, Kansas

Drilling Commenced: December 5, 1961
Drilling Completed: December 18, 1961
Drilling Contractor: Patton Drilling Company, Inc.
Total Depth - 3270'
I.P. - Dry & Abandoned

CASING RECORD:
8 5/8" 444.40 (o.a.) Set @ 450'
Cem. w/ 300 sacks

<u>Formation</u>	<u>Depth</u>
Blue shale & sand	200
Sandy clay	400
Red bed	460
Red bed, shale & shells	690
Shale & shells	1230
Red bed & shale	1625
Shale & anhydrite	1935
Shale & shells	2230
Lime & shale	2320
Shale & lime	2460
Lime & shale	2776
Shale & chalky lime	2860
Shale & lime	3117
Chalky lime	3211
Lime, chalky & sharp	3249
Lime	3270

RECEIVED
STATE CORPORATION COMMISSION

DEC 21 1961
CONSERVATION DIVISION
Wichita, Kansas

I hereby certify that this is a true and correct log of the above mentioned well.

STATE OF KANSAS)
COUNTY OF SEDGWICK) ss

[Signature]

Subscribed and sworn to before me, a notary public, in and for said County and State this 20th day of December, 1961.

[Signature]
Notary Public

My Commission expires July 21, 1962