

STATE OF KANSAS
STATE CORPORATION COMMISSION


Form CP-4

Give All Information Completely
Make Required Affidavit
Mail or Deliver Report to:
Conservation Division
State Corporation Commission
211 No. Broadway
Wichita, Kansas

WELL PLUGGING RECORD

Stevens County, Sec. 30 Twp. 34S Rge. 35 (E) W (W)

Location as "NE/CNW/SW" or footage from lines C SE SW
Lease Owner Cities Service Oil Company
Lease Name Stalcup "F" Well No. 1
Office Address P. O. Box 6
Character of Well (completed as Oil, Gas or Dry Hole) Dry Hole
Date well completed 7-30 19 66
Application for plugging filed 8-1 19 66
Application for plugging approved Verbal 7-30 19 66
Plugging commenced 7-30 19 66
Plugging completed 7-30 19 66
Reason for abandonment of well or producing formation Dry Hole

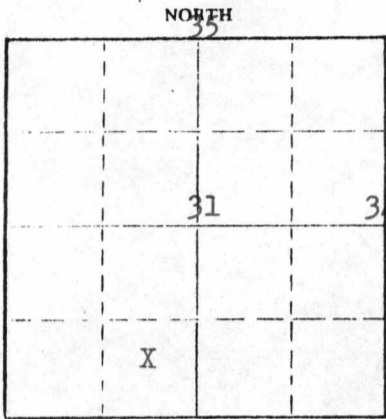

Locate well correctly on above Section Plat

If a producing well is abandoned, date of last production _____ 19____
Was permission obtained from the Conservation Division or its agents before plugging was commenced? Yes - Verbal

Name of Conservation Agent who supervised plugging of this well Ed Eves
Producing formation _____ Depth to top _____ Bottom _____ Total Depth of Well 6798 Feet
Show depth and thickness of all water, oil and gas formations.

OIL, GAS OR WATER RECORDS

CASING RECORD

FORMATION	CONTENT	FROM	TO	SIZE	PUT IN	PULLED OUT
				8 5/8	1702	None

Describe in detail the manner in which the well was plugged, indicating where the mud fluid was placed and the method or methods used in introducing it into the hole. If cement or other plugs were used, state the character of same and depth placed, from _____ feet to _____ feet for each plug set.

Mud	6793-6350'	
Cement	6350-6250'	35 sks.
Mud	6250-2800'	
Cement	2800-2600'	70 sks.
Mud	2600- 700'	
Cement	700- 600'	35 sks.
Mud	600- 45'	
Cement	45-Surface	15 sks.

RECEIVED
STATE CORPORATION COMMISSION
SEP 14 1966
CONSERVATION DIVISION
Wichita, Kansas

Plugs set with Halliburton

(If additional description is necessary, use BACK of this sheet)

Name of Plugging Contractor Rine Drilling Company
Address Wichita, Kansas

STATE OF Kansas, COUNTY OF Seward, ss. R. L. Higginbottom (employee of owner) or (owner or operator) of the above-described well, being first duly sworn on oath, says: That I have knowledge of the facts, statements, and matters herein contained and the log of the above-described well as filed and that the same are true and correct. So help me God.

(Signature) R. L. Higginbottom

P. O. Box 6, Liberal, Kansas (Address)

SUBSCRIBED AND SWORN to before me this 1st day of August, 1966

Calvin Lindsey
Calvin Lindsey
Notary Public.

My commission expires 11-5-66

ROTARY DRILLING LOG

OWNER: Cities Service Oil Company. CASING: Ran 53 jts. 8 5/8" 24#
 CONTRACTOR: Rine Drilling Company J-55 csg. - "A" - set @
 LEASE: Stalcup "F" No. 1 1702' RKB. Cement w/600
 LOCATION: SE SW Sec. 30-34S-35W Pozmix, 150 cu.ft. Strata
 Stevens County, Kansas Crete 6 and 1/4# Flocele/sk;
 100 sx Reg. w/2% CaCl

0 - 640	Sand & Shale
640 - 1250	Sand & Anhydrite
1250 - 1703	Sand & Shale
1703 - 2103	Anhydrite
2103 - 2824	Shale
2824 - 3025	Shale & Lime
3025 - 3140	Lime
3140 - 3253	Lime & Shale
3253 - 3533	Lime & Shale
3533 - 3824	Shale & Lime
3824 - 4060	Lime & Shale
4060 - 4163	Lime
4163 - 4422	Lime & Shale
4422 - 4762	Lime & Shale
4762 - 5060	Lime & Shale
5060 - 5188	Shale & Lime
5188 - 5382	Lime & Shale
5382 - 5468	Lime & Shale
5468 - 5523	Lime
5523 - 5611	Lime & Shale
5611 - 5976	Lime & Shale
5976 - 6236	Shale
6236 - 6325	Shale & Lime
6325 - 6412	Lime & Shale
6412 - 6498	Lime
6498 - 6562	Lime & Shale
6562 - 6748	Lime
6748 - 6800	Lime
6800	Total Depth

D&A

RECEIVED
 STATE COMMISSION

AUG 22 1966

We certify that the above log is true and correct to the best of our knowledge and belief.

CITIES SERVICE OIL COMPANY

By Chester A. Nenney
 Chester A. Nenney
 District Engineer