

STATE OF KANSAS  
STATE CORPORATION COMMISSION


Give All Information Completely  
Make Required Affidavit  
Mail or Deliver Report to:  
Conservation Division  
State Corporation Commission  
211 No. Broadway  
Wichita, Kansas

WELL PLUGGING RECORD

Sumner County, Sec. 25 Twp. 34S Rge. (E) 1 (W)

Location as "NE/CNW/SW" or footage from lines NW NW NW  
Lease Owner Thunderbird Drilling, Inc.  
Lease Name Moore Well No. 1  
Office Address 712 Union Center, Wichita 2, Kansas  
Character of Well (completed as Oil, Gas or Dry Hole) Dry Hole  
Date well completed July 4 19 60  
Application for plugging filed July 4 19 60  
Application for plugging approved July 4 19 60  
Plugging commenced July 4 19 60  
Plugging completed July 4 19 60  
Reason for abandonment of well or producing formation Dry Hole

NORTH

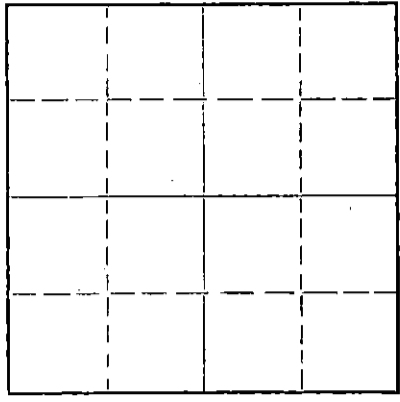

Locate well correctly on above Section Plat

If a producing well is abandoned, date of last production 19  
Was permission obtained from the Conservation Division or its agents before plugging was commenced? Yes

Name of Conservation Agent who supervised plugging of this well Fred Hampel  
Producing formation \_\_\_\_\_ Depth to top \_\_\_\_\_ Bottom \_\_\_\_\_ Total Depth of Well \_\_\_\_\_ Feet  
Show depth and thickness of all water, oil and gas formations.

OIL, GAS OR WATER RECORDS

CASING RECORD

FORMATION	CONTENT	FROM	TO	SIZE	PUT IN	PULLED OUT

Describe in detail the manner in which the well was plugged, indicating where the mud fluid was placed and the method or methods used in introducing it into the hole. If cement or other plugs were used, state the character of same and depth placed, from \_\_\_\_\_ feet to \_\_\_\_\_ feet for each plug set.

Hole filled to 210' with heavy mud. HOWCO plug and 1/3 sack hulls at 210' - 15 sacks cement mixed and poured through drillpipe. Hole filled with heavy mud to 35' - HOWCO plug with 1/3 sack hulls at 35' - 10 sacks cement on plug - 2 sacks cement in rathole.

RECEIVED  
STATE CORPORATION COMMISSION  
JUL 8 1960  
CONSERVATION DIVISION  
Wichita, Kansas

(If additional description is necessary, use BACK of this sheet)

Name of Plugging Contractor Thunderbird Drilling, Inc.  
Address 712 Union Center, Wichita 2, Kansas

STATE OF Kansas, COUNTY OF Sedgwick, ss.  
Charles W. Aikins, Jr. (Signature)  
Charles W. Aikins, Jr. (Address)  
712 Union Center, Wichita, Kansas

SUBSCRIBED AND SWORN TO before me this 7th day of July, 19 60  
Rose Marie Kuhlman Notary Public.  
My commission expires February 1, 1964



## DRILLERS LOG

#1 MOORE

LOCATION: NW NW NW - Section 25,  
Township 34 South, Range 1 West,  
Sumner County, Kansas

CONTRACTOR: Thunderbird Drilling, Inc.  
712 Union Center  
Wichita, Kansas

SURFACE CASING: 8-5/8" surface casing set at 200'  
with 180 sacks cement, 2% gel,  
3 sacks calcium chloride.

ELEVATION: 1136' K. B.  
1133' D. F.  
1131' G. L.

DRILLING COMMENCED: June 14, 1960

DRILLING COMPLETED: July 4, 1960


## WELL LOG

0 - 30	Surface Clay and Red Bed
30 - 50	Sand
50 - 225	Shale
225 - 850	Shale and Shells
850 - 930	Shale and Lime
930 - 1530	Shale and Shells
1530 - 2020	Shale and Lime
2020 - 2255	Lime and Shale
2255 - 2385	Shale and Lime
2385 - 2600	Lime and Shale
2600 - 2750	Shale and Lime
2750 - 2915	Shale, Sand and Lime
2915 - 2978	Lime and Shale
2978 - 3322	Shale and Lime
3322 - 3852	Lime and Shale
3852 - 3895	Lime
3895 - 3925	Lime and Chert
3925 - 3948	Cherty Lime
3948 - 3966	Cherty Lime and Shale
3966 - 3981	Chert and Lime
3981 - 3999	Lime, Shale and Chert
3999 - 4021	Shale, Chert and Lime
4021 - 4071	Lime, Shale and Chert
4071 - 4146	Shale, Lime and Chert
4146 - 4264	Shale and Lime
4264 - 4274	Sand
4274' - - -	Rotary Total Depth

RECEIVED  
STATE CORPORATION COMMISSION  
JUL 8 1960  
CONSERVATION DIVISION  
Wichita, Kansas


The undersigned, Charles W. Aikins, Jr., an officer of Thunderbird Drilling, Inc., hereby certifies that the above is a true and correct log of the formations encountered in the drilling of the #1 Moore as shown in the daily drilling reports.

THUNDERBIRD DRILLING, INC.

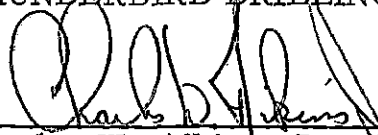  
Charles W. Aikins, Jr., President

Subscribed and sworn to before me this 7th day of July, 1960.

My commission expires 2-1-64.

  
Rose Marie Kuhlman, Notary Public