


WELL PLUGGING RECORD

Give All Information Completely  
Make Required Affidavit  
Mail or Deliver Report to:  
Conservation Division  
State Corporation Commission  
211 No. Broadway  
Wichita, Kansas

Morton County, Sec. 7 Twp. 33S Rge. (E) 40 (W)

Location as "NE/CNW/SW" or footage from lines C SW SE  
Lease Owner Anadarko Production Company  
Lease Name Low "E" Well No. 2  
Office Address P. O. Box 351 Liberal, Kansas  
Character of Well (completed as Oil, Gas or Dry Hole) Dry Hole  
Date well completed 7/30 19 66  
Application for plugging filed 7/29 19 66  
Application for plugging approved 7/29 19 66  
Plugging commenced 7/30 19 66  
Plugging completed 7/30 19 66  
Reason for abandonment of well or producing formation Dry Hole

NORTH

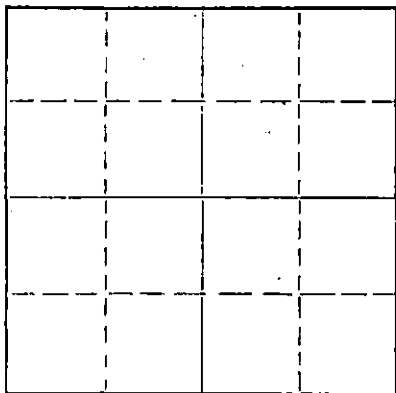

Locate well correctly on above  
Section Plat

If a producing well is abandoned, date of last production 19  
Was permission obtained from the Conservation Division or its agents before plugging was commenced? Yes

Name of Conservation Agent who supervised plugging of this well Ed Eves, Sublette, Kansas  
Producing formation None Depth to top Bottom Total Depth of Well 5970 Feet  
Show depth and thickness of all water, oil and gas formations.

OIL, GAS OR WATER RECORDS

CASING RECORD

FORMATION	CONTENT	FROM	TO	SIZE	PUT IN	PULLED OUT
				8-5/8"	1591'	None

Describe in detail the manner in which the well was plugged, indicating where the mud fluid was placed and the method or methods used in introducing it into the hole. If cement or other plugs were used, state the character of same and depth placed, from feet to feet for each plug set.

Spotted 50 sxs cement at 5900'  
Spotted 25 sxs cement at 5400'  
Spotted 35 sxs cement at 700'  
Spotted 15 sxs cement at 45' to surface.  
Complete at 8 a.m. 7/30/66.

RECEIVED  
STATE CORPORATION COMMISSION  
8-16-66  
AUG 16 1966

(If additional description is necessary, use BACK of this sheet)

Name of Plugging Contractor Lohman-Johnson  
Address 1737 Wichita Plaza Building, Wichita, Kansas

STATE OF Kansas, COUNTY OF Seward, ss.  
V. K. Downey (employee of owner) or (owner or operator) of the above-described

well, being first duly sworn on oath, says: That I have knowledge of the facts, statements, and matters herein contained and the log of the above-described well as filed and that the same are true and correct. So help me God.

(Signature) V. K. Downey, Supt. Liberal Production Division  
P. O. Box 351 Liberal, Kansas  
(Address)

SUBSCRIBED AND SWORN TO before me this 22nd day of August, 1966

My commission expires My Commission Expires Sept. 29, 1968

Donald L. Vangieson Notary Public.

**RECEIVED**

AUG 17 1966

**DRILLING &  
PRODUCTION**

15-129-00282-0000

DRILLER'S LOG

WELL NAME: Low "E" No. 2 ; COMPANY OPERATING: Anadarko Production Company

ADDRESS of COMPANY: Box 351 Liberal, Kansas

WELL LOCATION: C 1/4 SW 1/4 SE 1/4,  
660 ft. North of South line,  
3300 ft. East of West line; Sec. 7, Twp. 33S, Rge. 40W, Morton County, Kansas

DRILLING STARTED 7/13, 1966; DRILLING COMPLETED 7/29, 1966  
 WELL COMPLETED 7/30, 1966; WELL CONNECTED \_\_\_\_\_, 19\_\_\_\_

ELEVATION: 3343.8 ft. Ground Level; CHARACTER OF WELL (Oil, Gas, or Dry Hole)Dry Hole

OIL OR GAS SANDS OR ZONES - PERFORATIONS - ACIDIZING AND FRACTURING INFORMATION					
Name	From	To	No. of Shots	Gallons Used	Kind Used

CASING RECORD

Size	Amount Set	Sacks of Cement	Amount Pulled
8-5/8	1591	800	None

FORMATION RECORD

Formation	Top	Bottom	Formation	Top	Bottom
Sand	0	450	Lime with Chert	5790	5823
Sand & Red Bed	450	870	Lime	5823	5970
Surface Sand & Clay	870	1321	TOTAL DEPTH		5970
Shale & Sand	1321	1588			
Shale	1588	3892			
Lime	3892	4982			
Lime & Shale	4982	5101			
Shale & Sand	5101	5232			
Shale	5232	5327			
Shale w/Sand	5327	5372			
Shale	5372	5390			
Shale & Sand	5390	5641			
Lime	5641	5790			

*PLUGGED & ABANDONED*  
 AUG 7 1966  
 MORTON COUNTY, KANSAS

RESULTS of INITIAL PRODUCTION TEST: Plugged & abandoned on 7/30/66.