


STATE OF KANSAS  
STATE CORPORATION COMMISSION

WELL PLUGGING RECORD

Give All Information Completely  
Make Required Affidavit  
Mail or Deliver Report to  
Conservation Division  
State Corporation Comm.  
245 North Water  
Wichita, KS 67202

Morton County. Sec. 8 Twp. 33S Rge. 40 E/W  
Location as "NE/CNW $\frac{1}{4}$ /SW $\frac{1}{4}$ " or footage from lines \_\_\_\_\_

SE SE  
Lease Owner Anadarko Production Company  
Lease Name LOW "A" Well No. 9  
Office Address P. O. Box 351, Liberal, Kansas 67901  
Character of Well (Completed as Oil, Gas or Dry Hole) \_\_\_\_\_

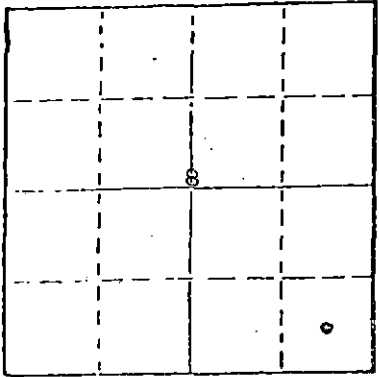

Locate well correctly on above  
Section Plot

DRY HOLE  
Date Well completed August 30 1981  
Application for plugging filed October 28 1981  
Application for plugging approved verbal August 30 1981  
Plugging commenced August 30 1981  
Plugging completed August 30 1981  
Reason for abandonment of well or producing formation \_\_\_\_\_

DRY HOLE  
If a producing well is abandoned, date of last production \_\_\_\_\_ 19\_\_\_\_

Was permission obtained from the Conservation Division or its agents before plugging was commenced? YES

Name of Conservation Agent who supervised plugging of this well Mr. Clarence Thomas  
Producing formation \_\_\_\_\_ Depth to top \_\_\_\_\_ Bottom \_\_\_\_\_ Total Depth of Well 5845'

Show depth and thickness of all water, oil and gas formations.

OIL, GAS OR WATER RECORDS

CASING RECORD

FORMATION	CONTENT	FROM	TO	SIZE	PUT IN	PULLED OUT
				8-5/8"	1488'	-0-

Describe in detail the manner in which the well was plugged, indicating where the mud fluid was placed and the method or methods used in introducing it into the hold. If cement or other plugs were used, state the character of same and depth placed, from \_\_\_\_\_ feet to \_\_\_\_\_ feet for each plug set.

Spotted 50 sxs common @ 2800', 50 sxs 1540-1440', 40 sxs @ 700, 5 sxs in rathole and mousehole. Heavy drilling mud was pumped between each plug, comp 8 am 8/30/81.

(If additional description is necessary, use BACK of this sheet)

Name of Plugging Contractor Gabbert-Jones, Inc.

RECEIVED  
STATE CORPORATION COMMISSION

OCT 30 1981

STATE OF KANSAS COUNTY OF SEWARD

CONSERVATION DIVISION  
Wichita, Kansas

Paul Campbell (employee of owner) or (owner of well) of the above-described well, being first duly sworn on oath, says: That I have knowledge of the facts, statements, and matters herein contained and the log of the above-described well as filed and that the same are true and correct. So help me God.

(Signature) Paul Campbell  
P. O. Box 351, Liberal, Kansas 67901  
(Address)

SUBSCRIBED AND SWORN TO before me this 29th day of October, 1981

STATE NOTARY PUBLIC  
BEVERLY J. WILLIAMS  
Seward County, Kansas  
My Appt. Exp. November 21, 1982

Beverly J. Williams  
Notary Public.

My commission expires November 21, 1982