


Give All Information Completely
Make Required Affidavit
Mail or Deliver Report to:
Conservation Division
State Corporation Commission
211 No. Broadway
Wichita, Kansas

WELL PLUGGING RECORD

NORTH

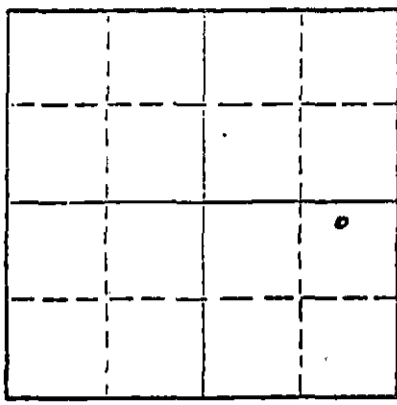

Locate well correctly on above Section Plat

Morton County, Sec. 8 Twp. 33S Rge. (E)40 (W)
Location as "NE/CNW/SE/SW" or footage from lines 660' FEL & 2453' FSL
Lease Owner Anadarko Production Company
Lease Name Low "A" Well No. 2
Office Address Box 351 Liberal, Kansas
Character of Well (completed as Oil, Gas or Dry Hole) Oil
Date well completed 11-19 19 63
Application for plugging filed 10-20 19 65
Application for plugging approved 12-10 19 65
Plugging commenced 12-17 19 65
Plugging completed 12-21 19 65
Reason for abandonment of well or producing formation Non-economical

If a producing well is abandoned, date of last production Sept. 14 19 65
Was permission obtained from the Conservation Division or its agents before plugging was commenced? Yes

Name of Conservation Agent who supervised plugging of this well Hugh E. Scott
Producing formation Lower Keyes Depth to top 5586' Bottom 5590' Total Depth of Well 5835 Feet
Show depth and thickness of all water, oil and gas formations.

OIL, GAS OR WATER RECORDS

CASING RECORD

FORMATION	CONTENT	FROM	TO	SIZE	PUT IN	PULLED OUT
Lower Keyes	Oil	5586'	5590'	20"	66'	
				8-5/8"	1500'	None
				4-1/2"	5697'	3020'

Describe in detail the manner in which the well was plugged, indicating where the mud fluid was placed and the method or methods used in introducing it into the hole. If cement or other plugs were used, state the character of same and depth placed, from _____ feet to _____ feet for each plug set.

Mixed 20 sxs cement. Pumped plug to 5010' with mud.
Shot off 4-1/2" casing @ 3020'. Pulled 4-1/2" casing to 700'.
Circulated hole w/ mud. Spotted 35 sxs cement thru 4-1/2" casing @ 700' displaced w/mud.
Filled hole w/mud to 40'.
15 sxs cement 40' to surface.
Completed 10 a.m. 12-21-65.

RECEIVED
STATE CORPORATION COMMISSION
DEC 30 1965
CONSERVATION DIVISION
Wichita, Kansas

(If additional description is necessary, use BACK of this sheet)
Name of Plugging Contractor Sargent's Casing Pulling Serv.
Address 1546 Clay Court - Liberal, Kansas

STATE OF Kansas COUNTY OF Seward ss.
V. K. Downey (employee of owner) or (owner or operator) of the above-described

well, being first duly sworn on oath, says: That I have knowledge of the facts, statements, and matters herein contained and the log of the above-described well as filed and that the same are true and correct. So help me God.

(Signature) V. K. Downey, Supt. Liberal Production Division
Box 351 Liberal, Kansas
(Address)

SUBSCRIBED AND SWORN TO before me this 23rd day of December, 1965
Donald L. Chapman
Notary Public.

DRILLER'S LOG

WELL NAME Low "A" #2 COMPANY OPERATING Anadarko Production Company
 ADDRESS of COMPANY Box 351, Liberal, Kansas
 WELL LOCATION C 1/2 NE 1/2 SE 1/2,
2453 ft. North of South line,
4632 ft. East of West line; Sec. 8 Twp. 33S Rge. 40W, Morton County, Kansas
 DRILLING STARTED October 18, 19 63 DRILLING COMPLETED November 5, 19 63
 WELL COMPLETED November 13, 19 63 WELL CONNECTED _____, 19 _____
 ELEVATION 3247.14 ft. Ground Level CHARACTER OF WELL (Oil, Gas, or Dry Hole) Oil

OIL OR GAS SANDS OR ZONES - PERFORATIONS - ACIDIZING AND FRACTURING INFORMATION					
Name	From	To	No. of Shots	Gallons Used	Kind Used
Keyes	5586	5590	16	250	10% NE

CASING RECORD

Size	Amount Set	Sacks of Cement	Amount Pulled
20" Conductor	66	8 yds	None
8 5/8	1500	750 sxs	None
4 1/2	5697	220 sxs	None

FORMATION RECORD

Formation	Top	Bottom	Formation	Top	Bottom
Sand & Clay	0	350			
Red Bed	350	840			
Shale & Sand	840	1502			
Lime & Shale	1502	3969			
Lime	3969	4090			
Lime & Shale	4090	5645			
Lime	5645	5835			
Total Depth	5835				

RECEIVED
 STATE CORPORATION COMMISSION
 FEB 1 1966
 CONSERVATION DIV.
 Wichita, Kansas

RESULTS of INITIAL PRODUCTION TEST: Flowed 128.66 Bbls in 5 hours, API Gravity 51.8 degrees at 60 degrees.