


WELL PLUGGING RECORD

Give All Information Completely
Make Required Affidavit
Mail or Deliver Report to:
Conservation Division
State Corporation Commission
212 No. Market
Wichita, Kansas

Morton County, Sec. 8 Twp. 33S Rge. (E) 40 (W)

Location as "NE/CNW/SW" or footage from lines C NE SW
Lease Owner Anadarko Production Company
Lease Name Low "A" Well No. 5
Office Address Box 351 Liberal, Kansas 67901
Character of Well (completed as Oil, Gas or Dry Hole) Oil
Date well completed November 27 19 64
Application for plugging filed November 25 19 69
Application for plugging approved December 1 19 69
Plugging commenced January 20 19 70
Plugging completed January 20 19 70
Reason for abandonment of well or producing formation Well would no longer produce in economical quantities.
If a producing well is abandoned, date of last production March 29 19 69
Was permission obtained from the Conservation Division or its agents before plugging was commenced? Yes

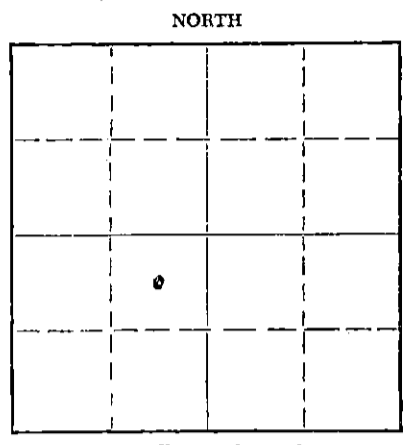

Locate well correctly on above Section Plat

Name of Conservation Agent who supervised plugging of this well Mr. Edgar Eves, Sublette, Kansas 67877
Producing formation Keyes Depth to top 5624 Bottom 5662 Total Depth of Well 5684 Feet
Show depth and thickness of all water, oil and gas formations.


OIL, GAS OR WATER RECORDS				CASING RECORD		
FORMATION	CONTENT	FROM	TO	SIZE	PUT IN	PULLED OUT
Keyes	Oil	5626	5632	8 5/8"	1527	None
				4 1/2"	5683	3400'

Describe in detail the manner in which the well was plugged, indicating where the mud fluid was placed and the method or methods used in introducing it into the hole. If cement or other plugs were used, state the character of same and depth placed, from _____ feet to _____ feet for each plug set.

Mixed 20 sacks cement and pumped plug with mud to 5400'
Spotted 35 sacks cement from 950' to 850'. Spotted 15 sacks cement from 45' to surface. Hole filled with mud between plugs.

RECEIVED
STATE CORPORATION COMMISSION
JAN 26 1970
CONSERVATION DIVISION
Wichita, Kansas

(If additional description is necessary, use BACK of this sheet)
Name of Plugging Contractor Sargent's Casing Pulling Service
Address Box 506 Liberal, Kansas 67901

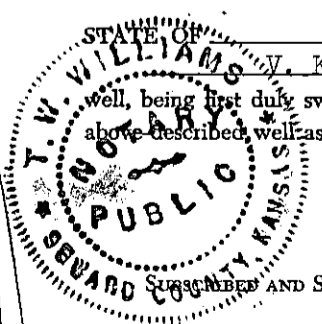

STATE OF Kansas, COUNTY OF Seward, ss.
W. K. Downey (employee of owner) or (owner or operator) of the above-described well, being first duly sworn on oath, says: That I have knowledge of the facts, statements, and matters herein contained and the log of the above-described well as filed and that the same are true and correct. So help me God.
(Signature) [Signature]
Box 351 Liberal, Kansas 67901
(Address)

SUBSCRIBED AND SWORN TO before me this 23rd day of January, 19 70
My Commission Expires April 28, 1971
My commission expires _____
J. W. Williams Notary Public.

15-129-10207-0000

DRILLER'S LOG

WELL NAME Low "A" No. 5

COMPANY OPERATING Anadarko Production Company
 ADDRESS of COMPANY Box 351, Liberal, Kansas

WELL LOCATION C 1/2 NE 1/4 SW 1/4,

1920 ft. North of South line,
1920 ft. East of West line; Sec. 6 Twp. 33S Rge. 10W, Morton County, Kansas

DRILLING STARTED 11-6, 1968
 WELL COMPLETED 11-27, 1968

DRILLING COMPLETED 11-21, 1968
 WELL CONNECTED _____, 1968

ELEVATION 3207.88 ft. Ground Level CHARACTER OF WELL (Oil, Gas, or Dry Hole) Oil

OIL OR GAS SANDS OR ZONES - PERFORATIONS - ACIDIZING AND FRACTURING INFORMATION					
Name	From	To	No. of Shots	Gallons Used	Kind Used
Kayoa	5025	5032	24	250	10% NE

RECEIVED
 STATE CORPORATION COMMISSION
 FEB 20 1970
 CONSERVATION DIVISION
 Wichita, Kansas

CASING RECORD

Size	Amount Set	Sacks of Cement	Amount Pulled
8-7/8	1247	720	
7-1/2	5003	210	

FORMATION RECORD

Formation	Top	Bottom	Formation	Top	Bottom
Total Depth	5024				

RESULTS of INITIAL PRODUCTION TEST: Stripped & flowed 134 bbls. of oil in 3 hours.