

STATE OF KANSAS
STATE CORPORATION COMMISSION

Form CP-4


Give All Information Completely
Make Required Affidavit
Mail or Deliver Report to:
Conservation Division
State Corporation Commission
211 No. Broadway
Wichita, Kansas

WELL PLUGGING RECORD

Morton County, Sec. 8 Twp. 33S Rge. 40W (E) (W)

Location as "NE/CNW&SW" or footage from lines C SW SW
Lease Owner: Anadarko Production Company
Lease Name: Low "A" Well No. 7
Office Address: Box 351, Liberal, Kansas
Character of Well (completed as Oil, Gas or Dry Hole) Dry Hole
Date well completed 12-12 19 64
Application for plugging filed 12-15 19 64
Application for plugging approved 19
Plugging commenced 12-12 19 64
Plugging completed 12-12 19 64
Reason for abandonment of well or producing formation Dry

NORTH

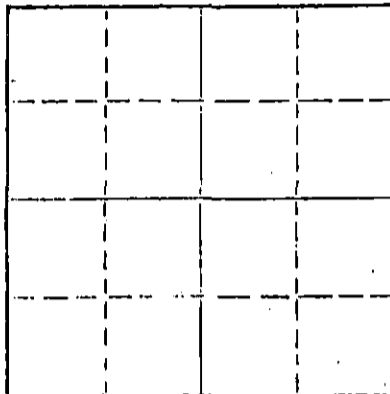

Locate well correctly on above
Section Plat

If a producing well is abandoned, date of last production 19
Was permission obtained from the Conservation Division or its agents before plugging was commenced? Yes

Name of Conservation Agent who supervised plugging of this well Hugh Scott
Producing formation Depth to top Bottom Total Depth of Well 5660 Feet
Show depth and thickness of all water, oil and gas formations:

OIL, GAS OR WATER RECORDS

CASING RECORD

FORMATION	CONTENT	FROM	TO	SIZE	PUT IN	PULLED OUT
				8-5/8"	1527'	None

Describe in detail the manner in which the well was plugged, indicating where the mud fluid was placed and the method or methods used in introducing it into the hole. If cement or other plugs were used, state the character of same and depth placed, from feet to feet for each plug set.
Spotted 50' sxs. cement @ 2602', 35 sxs. @ 686' and 15 sxs. @ 45'.

RECEIVED
STATE CORPORATION COMMISSION
12-18-64
DEC 18 1964

CONSERVATION DIVISION
Wichita, Kansas

(If additional description is necessary, use BACK of this sheet)
Name of Plugging Contractor Holm Drilling Company
Address Box 7505 Southside Station, Tulsa 5, Oklahoma

STATE OF KANSAS, COUNTY OF SEWARD, ss.
S. H. Neithercoat, Supt. Drilling & Prod. (employee of owner) or (owner or operator) of the above-described well, being first duly sworn on oath, says: That I have knowledge of the facts, statements, and matters herein contained and the log of the above-described well as filed and that the same are true and correct. So help me God.

(Signature) S. H. Neithercoat S. H. Neithercoat
Box 351, Liberal, Kansas (Address)

SUBSCRIBED AND SWORN TO before me this 15th day of December, 19 64

Donald L. Vangieson
Donald L. Vangieson Notary Public.

My Commission Expires Sept. 29, 1968

69

DRILLER'S LOG

WELL NAME: Low "A" No. 7; COMPANY OPERATING: Anadarko Production Company
 ADDRESS of COMPANY: Box 351, Liberal, Kansas

WELL LOCATION: C 1/4 SW 1/4 SW 1/4,
660 ft. North of South line,
660 ft. East of West line; Sec. 8, Twp. 33S, Rge. 40W, Morton County, Kansas

DRILLING STARTED 11-25, 1964; DRILLING COMPLETED 12-12, 1964
 WELL COMPLETED 12-12, 1964; WELL CONNECTED _____, 19____

ELEVATION: 3283.38 ft. Ground Level; CHARACTER OF WELL (Oil, Gas, or Dry Hole) Dry Hole

OIL OR GAS SANDS OR ZONES - PERFORATIONS - ACIDIZING AND FRACTURING INFORMATION					
Name	From	To	No. of Shots	Gallons Used	Kind Used

CASING RECORD

Size	Amount Set	Sacks of Cement	Amount Pulled
8-5/8"	1527'	750	

FORMATION RECORD

Formation	Top	Bottom	Formation	Top	Bottom
Surface sand & clay	0	40			
Sand	40	350			
Red bed & sand	350	495			
Red bed	495	875			
Shale & shells	875	990			
Gypsum	990	1120			
Sand	1120	1250			
Shale & shells	1250	2045			
Shale & lime	2045	3514			
Lime	3514	5306			
Shale & lime	5306	5660			
Total Depth	5660				

RECEIVED
 STATE CORPORATION COMMISSION
 DEC 18 1964
 CONSERVATION DIVISION
 Wichita, Kansas

RESULTS of INITIAL PRODUCTION TEST: _____