

15-129-20594-0000

RECEIVED

APR 19 1982

FORM CP-4

STATE OF KANSAS
STATE CORPORATION COMMISSION

WELL PLUGGING RECORD

PRODUCTION DEPT.
LIBERAL, KANSAS

Give All Information Completely
Make Required Affidavit
Mail or Deliver Report to
Conservation Division
State Corporation Comm.
245 North Water
Wichita, KS 67202

Morton County, Sec. 10 Twp. 33 Rge. 40 E/W
Location as "NE/CNW/SW" or footage from lines
C SW NE


Lease Owner Anadarko Production Co.
Lease Name Hayward "I" Well No. 2
Office Address Box 351 Liberal, Ks. 67901
Character of Well (Completed as Oil, Gas or Dry Hole)
Dry

Date Well completed 4/9 1982
Application for plugging filed 3/2 1982
Application for plugging approved 3/5 1982
Plugging commenced 4-7-82 19
Plugging completed 4-9-82 19

Reason for abandonment of well or producing formation
Non commercial value
If a producing well is abandoned, date of last production
None 19

Was permission obtained from the Conservation Division or
its agents before plugging was commenced? yes

Name of Conservation Agent who supervised plugging of this well Mr. Thomas
Producing formation Depth to top 5919 Bottom 5924 Total Depth of Well 6000
Show depth and thickness of all water, oil and gas formations.

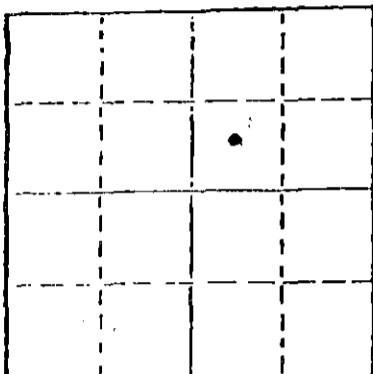

Locate well correctly on above
Section Plot

OIL, GAS OR WATER RECORDS

CASING RECORD

FORMATION	CONTENT	FROM	TO	SIZE	PUT IN	PULLED OUT
Surface				8 5/8"	1464'	0'
Production				4 1/2"	5984'	3067'

Describe in detail the manner in which the well was plugged, indicating where the mud fluid
was placed and the method or methods used in introducing it into the hold. If cement or other
plugs were used, state the character of same and depth placed, from feet to
feet for each plug set.

Pumped 2 sks. hulls & 30 sks. cement to 5120' - Pressured to 1000 lbs.
Shot pipe @ 3067' - layed down 4 jts. & pumped 25 sks. cement @ 2900'
Displaced w/mud to 1400'
Pumped 35 sks. cement 1400' to 1300'
Displaced w/mud to 500'
Pumped 25 sks. cement 500' to 425'
Displaced w/mud to 40'
Put bridge & 10 sks. cement 40' to 0'
Cut off 8 5/8", 42" below ground level & weld plate on top

(If additional description is necessary, use BACK of this sheet)

Name of Plugging Contractor Midwest Casing Pulling Service
Permit # 766

STATE OF KANSAS COUNTY OF HASKELL, ss.
I, Edgar J. Eves (Employee of owner) or (owner or operator)

of the above-described well, being first duly sworn on oath, says: That I have knowledge of
the facts, statements, and matters herein contained and the log of the above-described well
as filed and that the same are true and correct. So help me God.

(Signature) Edgar J. Eves
Box F, Sublette, Ks. 67877
(Address)

Subscribed and sworn to before me this 13th day of April, 1982

Sondra L Eves
Notary Public.

RECEIVED
STATE CORPORATION COMMISSION

MAY - 5 1982

My commission expires 12-6-84

CONSERVATION DIVISION
Wichita, Kansas

SONDRA L EVES
Haskell County, Ks.
My Appt. Exp. 12-6-84

GABBERT-JONES, INC.
WICHITA, KANSAS
DRILLERS' WELL LOG

Hayward "L-2"
SW-NE Sec 10-33S-40W
Morton County Kansas

Commenced: 1-8-82

Completed: 1-22-82

OPERATOR: ANADARKO PRODUCTION CO.

Depth		Formation	Remarks
From	To		
0	646	Sand	
646	1259	Sand-Redbed	Ran 35 jts of 24# 8 5/8" csg set @ 1464' Cemented w/
1259	1470	Sand-Redbed-Anhy	500 sks Posmix 4% Gel
1470	1510	Shale-Lime	2% CC + 200 sks Common
1510	2348	Lime-Shale	2% CC PD @ 9:30 p.m.
2348	2631	Shale-Lime	1-9-82
2631	2833	Lime-Shale	
2833	3041	Shale-Lime	
3041	6000	Lime-Shale	
	6000 - TD		Ran 144 jts of 4 1/2" csg set @ 5984' Cemented w/500 sks HB Lite - 275 sks 50/50 Posmix PD @ 5:00 a.m. 1-22-82

STATE OF KANSAS)
) SS
COUNTY OF SEDGWICK)

I, the undersigned, being duly sworn on oath, state that the above Drillers' Well Log is true and correct to the best of my knowledge and belief and according to the records of this office.

GABBERT-JONES, INC.

James S. Sutton II
JAMES S. SUTTON II

Subscribed and sworn to before me this 1st day of February, 1982.

Elizabeth J. Edwards
ELIZABETH J. EDWARDS-NOTARY PUBLIC

My Commission expires February 6, 1983.

