


STATE OF KANSAS
STATE CORPORATION COMMISSION

WELL PLUGGING RECORD

Give All Information Completely
Make Required Affidavit
Mail or Deliver Report to:
Conservation Division
State Corporation Commission
800 Bittling Building
Wichita, Kansas

Barber County. Sec. 5 Twp. 34S. Rge. (E) 13(W)
Location as "NE/CNW $\frac{1}{4}$ SW $\frac{1}{4}$ " or footage from lines NE, SE, NW,
Lease Owner Imperial Oil of Kansas, Inc.
Lease Name Blunk Well No. "C" 1
Office Address 903 Union National Bank Bldg. Wichita 2, Kans.
Character of Well (completed as Oil, Gas or Dry Hole) Dry Hole
Date well completed April 24th 19 56
Application for plugging filed April 23 19 56
Application for plugging approved April 24th 19 56
Plugging commenced April 24th 19 56
Plugging completed April 24th 3 P.M. 19 56
Reason for abandonment of well or producing formation.

NORTH

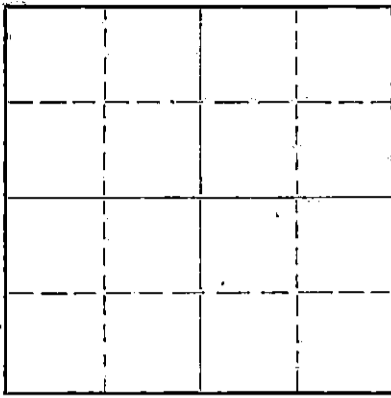

Locate well correctly on above
Section Flat

If a producing well is abandoned, date of last production 19
Was permission obtained from the Conservation Division or its agents before plugging was commenced? Yes.

Name of Conservation Agent who supervised plugging of this well Murl Rives.
Producing formation Depth to top Bottom Total Depth of Well 4976 Feet
Show depth and thickness of all water, oil and gas formations.

OIL, GAS OR WATER RECORDS

CASING RECORD

Formation	Content	From	To	Size	Put In	Pulled Out
				13"	28 237'	None

Describe in detail the manner in which the well was plugged, indicating where the mud fluid was placed and the method or methods used in introducing it into the hole. If cement or other plugs were used, state the character of same and depth placed, from feet to feet for each plug set.

Filled hole with heavy mud to 235 feet Set Bridge plug at 235 feet and
Cemented with 30 sacks cement, then filled hole with heavy mud to 15 feet
below cellar, then set bridge plug and cemented with 15 sacks cement

5-16-56

(If additional description is necessary, use BACK of this sheet)

Correspondence regarding this well should be addressed to Imperial Oil of Kansas, Inc.
Address 903 Union Natl Bank Bldg. Wichita 2, Kansas.

STATE OF Kansas, COUNTY OF Sedgwick, ss.
R. C. Patton (employee of owner) or (owner or operator) of the above-described well,
being first duly sworn on oath, says: That I have knowledge of the facts, statements, and matters herein contained and the log of the above-described well as filed and that the same are true and correct. So help me God.

(Signature) R.C. Patton
500 Orpheum Bldg. Wichita 2, Kansas.
(Address)

SUBSCRIBED AND SWORN to before me this 10 day of May, 19 56
T. P. Hendrick Notary Public.

My commission expires Oct 4th 1956

PLUGGING
FILE SEC 5 T34 R 13W
BOOK PAGE 57 LINE 3

Imperial Oil of Kansas, Inc.
Blunk Well # "C" 1
Total Depth 4976'
Comm. 4/2/56
Comp. 4/24/56
Contractor Patton Drilling Company, Inc.

Location NE,SE,NW, Section 5-T34S-
R13 West Barber County, Kansas.
CASING RECORD.
13" O.D. Spiral Weld at 237'
Cemented with 250 Sacks Cement

Surface sand & Gravel	103
Red beds Shells	225
Red Beds Gyp Shells	260
Red Beds & Shells	800
Shale & Shells	1550
Salt & Shale	1600
Lime & Shale	2055
Anhyd. & Shale	2164
Lime & Shale	3297
Shale	3385
Lime & Shale	3665
Lime	3765
Lime & Shale	3940
Sandy Shale	4025
Sand & Sandy Shale	4034
Lime & Shale	4158
Lime	4196
Lime & Shale	4215
Sand & Sandy Shale	4274
Lime & Shale	4429
Lime	4471
Lime & Shale	4542
Lime	4567
Lime & Shale	4764
Lime	4808
Lime & Shale	4898
Lime	4976
Total Depth	4976

11' from Kelly Bushing to Ground level

STATE OF Kansas COUNTY OF Sedgewick ss,

I, the undersigned, being duly sworn, on oath state that the above statement and log is a true and correct record and log of the well drilled at the location above described.

REC'D
COMMISSION
MAY 16 1956
REGISTRATION DIVISION
Wichita, Kansas

PATTON DRILLING COMPANY, INC.

By P. C. Patton

Subscribed and sworn to before me this 8th day of May 1956.

T. P. Hendrick
Notary Public. T. P. Hendrick

My Commission expires Oct 4th 1956.

PLUGGING
FILE SEC 5 T. 34 R. 13W
BOOK PAGE 57 LINE 3