


STATE OF KANSAS
STATE CORPORATION COMMISSION

WELL PLUGGING RECORD

Give All Information Completely
Make Required Affidavit
Mail or Deliver Report to
Conservation Division
State Corporation Comm.
245 North Water
Wichita, KS 67202

Barber County, Sec. 5 Twp. 34S Rge. 13W E/W
Location as "NE/CNW $\frac{1}{4}$ SW $\frac{1}{4}$ " or footage from lines
C SE/4 NE/4
Lease Owner Patton Oil Company
Lease Name Falen-Hoimes Well No. 1
Office Address 5660 S. Syracuse Circle, Englewood, Colo. 80110
Character of Well (Completed as Oil, Gas or Dry Hole) D & A

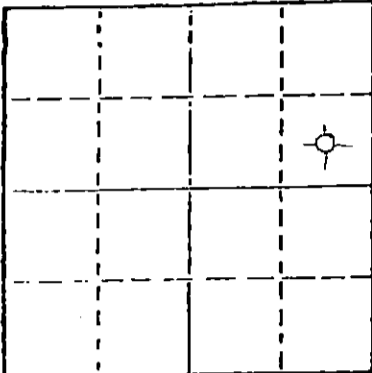

Locate well correctly on above
Section Plot

Date Well completed February 20, 1977
Application for plugging filed February 20, 1977
Application for plugging approved February 20, 1977
Plugging commenced February 20, 1977
Plugging completed February 20, 1977
Reason for abandonment of well or producing formation D & A

If a producing well is abandoned, date of last production 19

Was permission obtained from the Conservation Division or its agents before plugging was commenced? Yes

Name of Conservation Agent who supervised plugging of this well G. R. Biberstein
Producing formation _____ Depth to top _____ Bottom _____ Total Depth of Well 5492'
Show depth and thickness of all water, oil and gas formations. JUN 03 1977
6-2-77

OIL, GAS OR WATER RECORDS

CONSERVATION DIVISION
Wichita, Kansas CASING RECORD

FORMATION	CONTENT	FROM	TO	SIZE	PUT IN	PULLED OUT
				8 5/8"	449.25'	-0-

Describe in detail the manner in which the well was plugged, indicating where the mud fluid was placed and the method or methods used in introducing it into the hold. If cement or other plugs were used, state the character of same and depth placed, from _____ feet to _____ feet for each plug set.

Plug @ 450' w/35 sx cement
Plug @ 40' w/12 sx cement
5 sx cement in rathole

(If additional description is necessary, use BACK of this sheet)


Name of Plugging Contractor Red Tiger Drilling Company
1720 KSB&T Building, Wichita, Kansas 67202

STATE OF Kansas COUNTY OF Sedgwick, ss. contractor
Gloria Fawcett (employee of owner) xxxxxxxxx
of the above-described well, being first duly sworn on oath, says: That I have knowledge of the facts, statements, and matters herein contained and the log of the above-described well as filed and that the same are true and correct. So help me God.

(Signature) Gloria Fawcett
1720 KSB&T Building, Wichita, Kansas 67202
(Address)

SUBSCRIBED AND SWORN TO before me this 22nd day of February, 1977.

My commission expires _____
Joyce A. Hagermann
Notary Public.

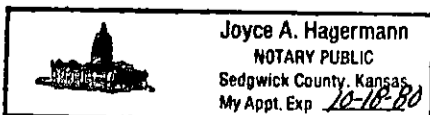

DRILLERS LOG

No. 1 Falen-Holmes

CASING RECORD:	COMPANY:	Patton Oil Company	DESCRIPTION:
8 5/8" @ 457' w/350 sx cmt.	CONTRACTOR:	Red Tiger Drilling Company	C SE/4 NE/4 Sec. 5-T34S-R13W Barber County, Kansas
	COMMENCED:	February 3, 1977	
	COMPLETED:	February 20, 1977	
TOTAL DEPTH: 5,492'			ELEVATION: 1,869' KB

<u>FORMATION</u>	<u>FROM</u>	<u>TO</u>	<u>REMARKS</u>
Sand & Shale	0	1100	
Shale	1100	1841	
Anhydrite	1841	1875	
Shale	1875	1940	
Shale & Lime	1940	2175	
Lime & Shale	2175	2450	
Lime	2450	2595	
Lime & Shale	2595	2875	
Lime	2875	4875	
Mississippi	4875	4895	
Lime	4895	4940	
Mississippi Chat	4940	4951	
Lime	4951	5450	
Sand & Lime	5450	5492	
RTD		5492	

APR 25 1977

I certify that this is a true and correct copy of the above log to the best of my knowledge.

RED TIGER DRILLING COMPANY

Gloria Fawcett
Gloria Fawcett

Subscribed and sworn to before me this 22nd day of February, 1977.

Joyce A. Hagermann
Notary Public

