


STATE OF KANSAS
STATE CORPORATION COMMISSION
CONSERVATION DIVISION
P. O. BOX 17027
WICHITA, KANSAS 67217

FORM CP-4

WELL PLUGGING RECORD

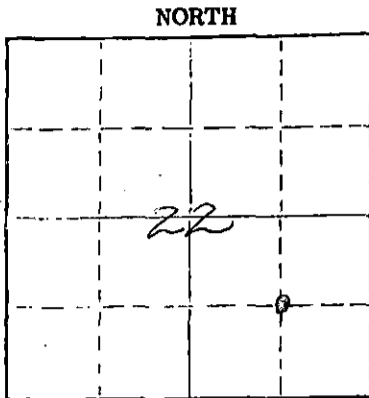

Locate well correctly on above Section Plot

Meade County, Sec. 22 Twp. 34S Rgs. (E)29 (W)
Location as "NE/CNWSW" or footage from lines C SE
Lease Owner Texaco Inc.
Lease Name H. G. Adams "D" O/A Well No. 1
Office Address P.O. Box 2420, Tulsa, OK 74102
Character of Well (completed as Oil, Gas or Dry Hole) Gas
Date well completed 12/21/59 19
Application for plugging filed 11/5/75 19
Application for plugging approved 11/10/75 19
Plugging commenced 12/13/75 19
Plugging completed 12/13/75 19
Reason for abandonment of well or producing formation uneconomical
If a producing well is abandoned, date of last production 8/22/74 19
Was permission obtained from the Conservation Division or its agents before plugging was commenced? Yes

Name of Conservation Agent who supervised plugging of this well Clarence Thomas
Producing formation Council Grove Depth to top 2969 Bottom Total Depth of Well 4466 Feet
Show depth and thickness of all water, oil and gas formations.

OIL, GAS OR WATER RECORDS

CASING RECORD

FORMATION	CONTENT	FROM	TO	SIZE	PUT IN	PULLED OUT
				7"	3450'	2716'

Describe in detail the manner in which the well was plugged, indicating where the mud fluid was placed and the method or methods used in introducing it into the hole. If cement or other plugs were used, state the character of same and depth placed, from feet to feet for each plug set.

3238-3100' w/20 sx cmt
3100-1200' w/hvy mud
1200-1100' w/35 sx cmt
1100-600' w/hvy mud
600-500' w/40 sx cmt
500-35' w/hvy mud
35-5' w/15 sx cmt

RECEIVED
STATE CORPORATION COMMISSION
JAN 9 1976
1-9-76
CONSERVATION DIVISION
Wichita, Kansas

PLUGGING COMPLETE

(If additional description is necessary, use BACK of this sheet)
Name of Plugging Contractor Sargent's Casing Pulling Service
Address P.O. Box 506, Liberal, Kansas 67901

STATE OF Oklahoma COUNTY OF Tulsa ss.
F. E. Anderson (employee of owner) or ~~owner or operator~~ of the above-described

well, being first duly sworn on oath, says: That I have knowledge of the facts, statements, and matters herein contained and the log of the above-described well as filed and that the same are true and correct. So help me God.

(Signature) F. E. Anderson Oper. Supt.
F. E. ANDERSON
P.O. Box 2420, Tulsa, OK 74102
(Address)

Subscribed and sworn to before me this 7th day of January, 1976.

My commission expires 11-25-78 W. M. Tolle Notary Public.

15-119-10319-0000

Texaco Inc.
Tulsa, Oklahoma

Tulsa, Oklahoma
December 16, 1959

CONTRACTOR: Stickle Drilling Company
Drilling Commenced: November 30, 1959
Drilling Completed: December 13, 1959

H. G. Adams D-1 SE/4 Sec.
22-34S-29W, Meade County,
Kansas.

DRILLERS LOG

Depth Figures Indicate Base Of Formation

Surface	0
Shale & Sand	270
Shale	305
Sand	415
Red Bed & Shells	700
Red Bed & Gypson	1115
Gypson	1365
Shale & Lime	1605
Shale & Shells	2100
Shale & Lime	2620
Lime & Shale	2680
Lime & Sand	2840
Lime & Shale	3490
Chaiky Lime & Shale	3595
Lime & Shale	3805
Sandy Lime - Shale	3990
Shale & Lime	4320
Lime & Shale	4425
Lime	4466 TD

I, Fred E. Stickle hereby certify the above to be a true and complete
Drillers Log of Texaco Inc. H.G. Adams D-1 SE/4 Section 22-34S-29W,
Meade County, Kansas.


Fred E. Stickle


Notary Public

RECEIVED
STATE CORPORATION COMMISSION

NOV 10 1975

My Commission Expires

CONSERVATION DIVISION
Wichita, Kansas