

STATE OF KANSAS  
STATE CORPORATION COMMISSION

WELL PLUGGING RECORD

Give All Information Completely  
Make Required Affidavit  
Mail or Deliver Report to  
Conservation Division  
State Corporation Comm.  
245 North Water  
Wichita, KS 67202

Meade County. Sec. 22 Twp. 34S Rge. 29 W  
Location as "NE/CNW|SW|" or footage from lines \_\_\_\_\_

C NE NE  
Lease Owner Mesa Petroleum

Lease Name Adams Well No. #2-22

Office Address P. O. Box 1869 Liberal, KS 67901

Character of Well (Completed as Oil, Gas or Dry Hole) \_\_\_\_\_  
dry hole

Date Well completed 3-12 1981

Application for plugging filed 4-9 1981

Application for plugging approved 4-9 1981

Plugging commenced 4-9 1981

Plugging completed 4-9 1981

Reason for abandonment of well or producing formation \_\_\_\_\_  
dry hole

If a producing well is abandoned, date of last production \_\_\_\_\_


n/a 1981

Was permission obtained from the Conservation Division or its agents before plugging was commenced? yes

Name of Conservation Agent who supervised plugging of this well Clarence Thomas

Producing formation \_\_\_\_\_ Depth to top \_\_\_\_\_ Bottom \_\_\_\_\_ Total Depth of Well \_\_\_\_\_

Show depth and thickness of all water, oil and gas formations.

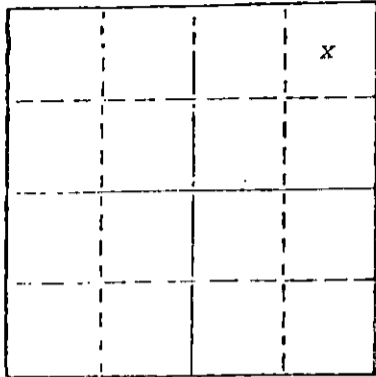

Locate well correctly on above Section Plot

OIL, GAS OR WATER RECORDS

CASING RECORD

FORMATION	CONTENT	FROM	TO	SIZE	PUT IN	PULLED OUT

Describe in detail the manner in which the well was plugged, indicating where the mud plug was placed and the method or methods used in introducing it into the hold. If cement or other plugs were used, state the character of same and depth placed, from \_\_\_\_\_ feet to \_\_\_\_\_ feet for each plug set.

Well plugged as follows:  
35 sx cement @ 628-513'  
10 sx cement @ 0-40'

RECEIVED  
STATE CORPORATION COMMISSION  
APR 16 1981  
CONSERVATION DIVISION  
Wichita, Kansas

(If additional description is necessary, use BACK of this sheet)

Name of Plugging Contractor Halliburton

STATE OF Kansas COUNTY OF Seward, ss.  
Ned E. Lowry, Agent (employee of owner) or (owner or operator)

of the above-described well, being first duly sworn on oath, says: That I have knowledge of the facts, statements, and matters herein contained and the log of the above-described well as filed and that the same are true and correct. So help me God.


(Signature) Ned E. Lowry, Agent

Ned E. Lowry  
P. O. Box 1869

(Address)

SUBSCRIBED AND SWORN to before me on this 14th day of April, 1981

My commission expires \_\_\_\_\_

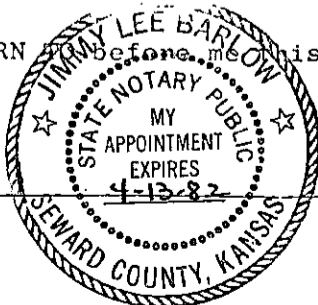

Jimmy Lee Barlow  
Notary Public.