

# ORIGINAL

SIDE ONE

STATE CORPORATION COMMISSION OF KANSAS  
OIL & GAS CONSERVATION DIVISION  
RECOMPLETION FORM  
ACO-2 AMENDMENT TO WELL HISTORY

API NO. 15- 119-20688 00-01

County Meade

C N/2 SW Sec. 29 Twp. 34S Rge. 30 XX East West

1980 Ft. North from Southeast Corner of Section

3960 Ft. West from Southeast Corner of Section  
(NOTE: Locate well in section plat below.)

Lease Name Adams Well # 1-29

Field Name Wildcat

Producing Formation Morrow Sand

Elevation: Ground 2587 KB

Operator: License # 5225

Name: Quinque Operating Company

Address: P O Box 2738

City/State/zip: Liberal, KS 67905

Purchaser: Vintage Pipeline, Inc.

Operator Contact Person: Michael Moore  
Phone: (316) 624-2578

Designate Type of Original Completion  
 New Well  Re-Entry  Workover

Date of Original Completion 2-19-85

Name of Original Operator Quinque Operating Co.

Original Well Name Adams 1-29


Date of Recompletion: 3/3/91

Commenced 3/5/91 Completed 3/5/91  
Re-entry  Workover

Designate Type of Recompletion/Workover:  
 Oil  SWD  Temp. Abd.  
 Gas  Inj  Delayed Comp.  
 Dry  Other (Core, Water Supply, etc.)

Deepening  Re-perforation  
 Plug Back  PBTB  
 Conversion to Injection/Disposal

Is recompleted production:  
 Commingled Docket No. \_\_\_\_\_  
 Dual Completion Docket No. \_\_\_\_\_  
 Other (Disposal or Injection?)  
Docket No. D-26,189

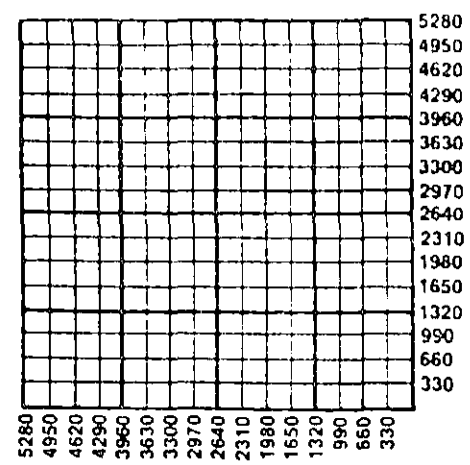

**K.C.C. OFFICE USE ONLY**  
F  Letter of Confidentiality Attached  
C  Wireline Log Received  
C  Drillers Timelog Received  
  
Distribution  
 KCC  SWD/Rep  NGPA  
 KGS  Plug  Other (Specify)

RECEIVED  
STATE CORPORATION COMMISSION  
MAR - 6 1991  
CONSERVATION DIVISION  
Wichita, Kansas

**INSTRUCTIONS:** This form shall be completed in triplicate and filed with the Kansas Corporation Commission, 200 Colorado Derby Building, Wichita, Kansas 67202, within 120 days of the recompletion of any well. Rules 82-3-107 and 82-3-141 apply. Information on side two of this form will be held confidential for a period of 12 months if requested in writing and submitted with the form. See rule 82-3-107 for confidentiality in excess of 12 months. One copy of any additional wireline logs and driller's time logs (not previously submitted) shall be attached with this form. Submit ACO-4 or ACO-5 prior to or with this form for approval of commingling or dual completions. Submit CP-1 with all plugged wells. Submit CP-111 with all temporarily abandoned wells. NOTE: Conversion of wells to either disposal or injection must receive approval before use; submit form U-1.

All requirements of the statutes, rules and regulations promulgated to regulate the oil and gas industry have been fully complied with and the statements herein are complete and correct to the best of my knowledge.

Signature [Signature] Title President Date 3/5/91

Subscribed and sworn to before me this 5th day of March 19 91

Notary Public [Signature] Date Commission Expires 11/02/92



SIDE TWO

Operator Name Quinque Operating Co. Lease Name Adams Well # 1-29

Sec. 29 Twp. 34S Rge. 30  East  West

County Meade

RECOMPLETION FORMATION DESCRIPTION

Log  Sample

Name \_\_\_\_\_ Top \_\_\_\_\_ Bottom \_\_\_\_\_

ADDITIONAL CEMENTING/SQUEEZE RECORD

Purpose:	Depth		Type of Cement	# Sacks Used	Type and Percent Additives
	Top	Bottom			
<input type="checkbox"/> Perforate					
<input type="checkbox"/> Protect Casing					
<input type="checkbox"/> Plug Back TD					
<input type="checkbox"/> Plug Off Zone					

Shots Per Foot	PERFORATION RECORD		Acid, Fracture, Shot, Cement Squeeze Record (Amount and Kind of Material Used)
	Specify	Footage of Each Interval Perforated	

PBTD 5856' Plug Type cast iron Bridge plug

TUBING RECORD

Size 2-3/8" Set At 4320' Packer At 4320' Was Liner Run

Date of Resumed Production, Disposal or Injection waiting on MIT

Estimated Production Per 24 Hours Oil \_\_\_\_\_ Bbls. Water \_\_\_\_\_ Bbls. Gas \_\_\_\_\_ Mcf

Disposition of Gas:  Vented  Sold  Used on Lease (If vented, submit ACO-18.)

