


STATE OF KANSAS  
STATE CORPORATION COMMISSION

WELL PLUGGING RECORD

Give All Information Completely  
Make Required Affidavit  
Mail or Deliver Report to  
Conservation Division  
State Corporation Comm.  
245 North Water  
Wichita, KS 67202

Harper County, Sec. 2 Twp. 34S Rge. 8W E/W  
Location as "NE/CNW $\frac{1}{4}$ SW $\frac{1}{4}$ " or footage from lines  
W/2 SW SE

Lease Owner McCoy Petroleum Corporation  
Lease Name Ritter A Well No. 1  
Office Address One Main Place - Suite 410 Wichita Ks. 67202  
Character of Well (Completed as Oil, Gas or Dry Hole)  
Dry Hole

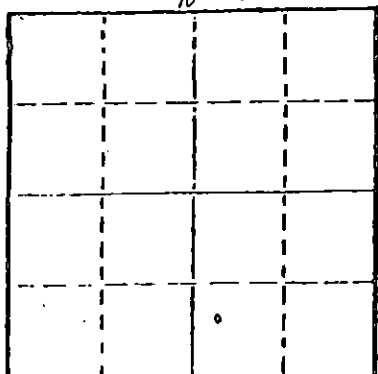

Locate well correctly on above  
Section Plot

Date Well completed 9-10 1982  
Application for plugging filed 9-10 1982  
Application for plugging approved 9-10 1982  
Plugging commenced 9-10 1982  
Plugging completed 9-10 1982  
Reason for abandonment of well or producing formation  
Dry Hole

If a producing well is abandoned, date of last production  
19

Was permission obtained from the Conservation Division or  
its agents before plugging was commenced? Yes

Name of Conservation Agent who supervised plugging of this well Maurice Leslie  
Producing formation Depth to top Bottom Total Depth of Well  
Show depth and thickness of all water, oil and gas formations.

OIL, GAS OR WATER RECORDS

CASING RECORD

FORMATION	CONTENT	FROM	TO	SIZE	PUT IN	PULLED OUT
Surface Pipe		-0-	265	8 5/8"	265	None

Describe in detail the manner in which the well was plugged, indicating where the mud fluid  
was placed and the method or methods used in introducing it into the hold. If cement or other  
plugs were used, state the character of same and depth placed, from feet to  
feet for each plug set.

Filled hole with heavy mud:

#1 Plug set @ 650' with 60 sacks cement

#2 Plug set @ 260' with 40 sacks cement

#3 Plug set @ 40' with 10 sacks cement

#4 plug set (in rat hole with 10 sacks cement

(If additional description is necessary, use BACK of this sheet)

Name of Plugging Contractor Sweetman Drilling Inc.

STATE OF Kansas COUNTY OF Barton, ss.

Gary L. Hawk (employee of owner) or (owner or operator)  
of the above-described well, being first duly sworn on oath, says: That I have knowledge of  
the facts, statements, and matters herein contained and the log of the above-described well  
as filed and that the same are true and correct. So help me God.

(Signature) Gary L. Hawk  
Box 645, Great Bend, Ks. 67530  
(Address)


SUBSCRIBED AND SWORN TO before me this 15th day of September, 19 82

Walter A. Becker  
RECEIVED Notary Public.  
STATE CORPORATION COMMISSION

My commission expires September 4, 1985

SEP 22 1982

CONSERVATION DIVISION  
Wichita, Kansas

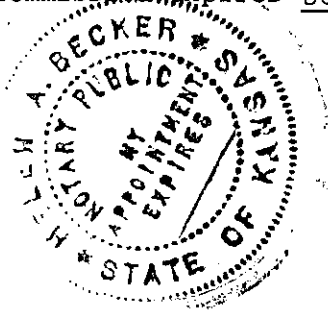

WELL LOG  
Ritter A #1  
W/2 SW SE 2-34S-8W  
Harper County, Kansas

Name of Operator: McCoy Petroleum Corporation  
One Main Place - Suite 410  
Wichita, Kansas 67202

Date Plugged: September 10, 1982

<u>FROM</u>	<u>TO</u>	
0	268	Red Bed
268	825	Red Bed and Shale
825	1385	Shale
1385	4680	Lime and Shale
4680	4715	Miss.
4715		Total Depth

STATE OF KANSAS

COUNTY OF BARTON ss

Gary L. Hawk, Secretary of Sweetman Drilling, Inc., being first duly sworn on oath says: That I have knowledge of the facts, statements and matters herein contained and the log of the above described well as filed and that the same are true and correct.

Gary L. Hawk  
Gary L. Hawk

Subscribed and sworn before me this 15th day of September, 1982.

Walter A. Becker  
Notary Public                      Barton County

My Commission expires 9-4-85

