

STATE OF KANSAS
STATE CORPORATION COMMISSION

Give All Information Completely
Make Required Affidavit
Mail or Deliver Report to:
Conservation Division
State Corporation Commission
800 Biting Building
Wichita, Kansas

WELL PLUGGING RECORD

Barber County, Sec. 11 Twp. 34 Rge. (E) 11 (W)

Location as "NE/CNW/SW" or footage from lines NW NW NE

Lease Owner Rupp-Ferguson Oil Co.

Lease Name Koontz Well No. 1

Office Address 523 Petroleum Bldg., Wichita, Kansas

Character of Well (completed as Oil, Gas or Dry Hole) Dry Hole

Date well completed 8-18-54 19

Application for plugging filed 8-19-54 19

Application for plugging approved 8-19-54 19

Plugging commenced 8-25-54 19


Plugging completed 8-31-54 19

Reason for abandonment of well or producing formation

Non-commercial

If a producing well is abandoned, date of last production 19

Was permission obtained from the Conservation Division or its agents before plugging was commenced? Yes

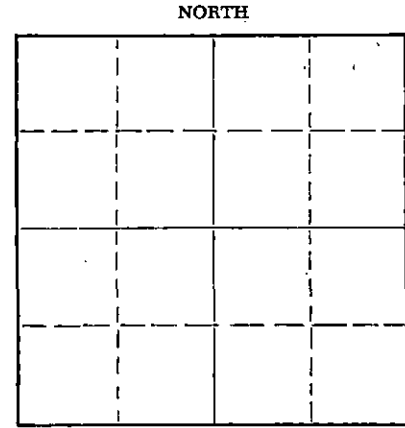

Locate well correctly on above Section Flat

Name of Conservation Agent who supervised plugging of this well Merle Rives

Producing formation Depth to top Bottom Total Depth of Well 5214 Feet

Show depth and thickness of all water, oil and gas formations.

OIL, GAS OR WATER RECORDS

CASING RECORD

FORMATION	CONTENT	FROM	TO	SIZE	PUT IN	PULLED OUT
				10 3/4"	257'	0
				5 1/2"	4761'	3768'

Describe in detail the manner in which the well was plugged, indicating where the mud fluid was placed and the method or methods used in introducing it into the hole. If cement or other plugs were used, state the character of same and depth placed, from feet to feet for each plug set.

Lane Wells plug set at 4590' and casing was perforated from 4580' to 4588'. Filled hole with sand from 4590' to 4570' and ran 5 sacks of cement. Mudded hole to 265', set a 10' rock bridge and ran 25 sacks of cement at 255'. Mudded hole to 25', set a rock bridge and ran 10 sacks of cement on top. Plugging completed.

(If additional description is necessary, use BACK of this sheet)

Name of Plugging Contractor West Supply Co., Inc.

Address Chase, Kansas

STATE OF Kansas, COUNTY OF Sedgwick, ss. L. W. Knox

(employee of owner) or (owner/landowner) of the above-described well, being first duly sworn on oath, says: That I have knowledge of the facts, statements, and matters herein contained and the log of the above-described well as filed and that the same are true and correct. So help me God.

(Signature) [Signature]

523 Petroleum Bldg., Wichita, Kansas (Address)

SUBSCRIBED AND SWORN TO before me this 7th day of September, 1954

[Signature] Notary Public.

My commission expires 6-4-55

PLUGGING
FILE SEC 11 T 34 R 11W
BOOK PAGE 58 LINE 12

RECEIVED
STATE CORPORATION COMMISSION
SEP - 8 1954
CONSERVATION DIVISION
Wichita, Kansas

CONTRACTOR'S WELL LOG

KOONTZ #1
 NW NW NE, Sec. 11-34-11W,
 Barber County, Kansas

D & A

Commenced: 7-11-54
 Completed: 8-4-54
 257' 10 3/4" Surface Casing
 4761' 5 1/2" casing
 R.T.D. 5214

Elev. 1409 KB

470 red bed & shells
 811 red rock, shale & shells
 850 shale & shells
 895 Anh. broken
 1340 shale & shells
 1450 salt
 1535 shale & shells
 3503 shale & lime
 3576 sand & shale
 3635 sand, lime & shale
 3702 lime & shale
 3712 sand & shale
 4219 lime & shale
 4448 lime
 4576 lime & shale
 4598 chert & lime
 4647 chert
 4738 cherty lime & shale
 4881 shale & lime
 4979 Viola
 5008 Simpson
 5020 Sandstone
 5105 sandy shale
 5139 shale
 5176 sand-shale
 5214 Arb.

Tops:

Elgin Sand	3503 (-2094)
Douglas Sand Zone	3702 (-2293)
Sand (Layton equiv.)	4030 (-2621)
Kansas City Lime	4150 (-2741)
Mississippian	4576 (-3167)
Kinderhook Shale	4744 (-3335)
Chattanooga Shale	4847 (-3438)
Misener Sand	4873 (-3464)
Viola Lime	4880 (-3471)
Simpson	4979 (-3570)
Simpson Sand	5000 (-3591)
Arbuckle Dolomite	5176 (-3767)
R.T.D.	5214 (-3805)

DST 4580-4598, open 1 hr., rec. 40' mud, BHP 1480#.

DST 4597-4647, Open 2 hrs, rec. 1020' fluid, top 660' oil & gcm, bottom 360' muddy SW, good oil cut at top to slight at bottom, BHP 1740#.

DST 4980-5008, Open 2 hrs., rec. 3200' SW, BHP 1870.

Perf. 33/4606-14, rec. 65' fluid, 90% water. Hydrafrac, swab. 20 BFPH, 90% water. Perf. 4580-88. Rec. 18' fluid, 90% water. Hydrafrac, rec. 5-10 BWPH.

PLUGGING
 FILE SEC 11-34-11W
 BOOK PAGE 58 LINE 12

RECEIVED
 STATE GEOLOGICAL COMMISSION
 DEPT. OF
 CONSERVATION DIVISION
 Wichita, Kansas