


Give All Information Completely
Make Required Affidavit
Mail or Deliver Report to:
Conservation Division
State Corporation Commission
211 No. Broadway
Wichita, Kansas

WELL PLUGGING RECORD

NORTH

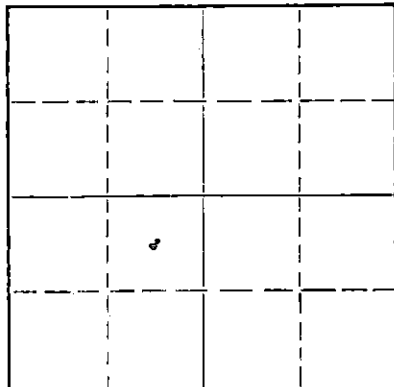

Locate well correctly on above
Section Plat

County. Barber Sec. 15 Twp. 34 Rge. 11 (E) (W)
Location as "NE/CNW/SW" or footage from lines. NE SW
Lease Owner CLARKE CORPORATION
Lease Name Schepherd Well No. #1
Office Address Medicine Lodge
Character of Well (completed as Oil, Gas or Dry Hole) Oil
Date well completed _____ 19____
Application for plugging filed Sept 21 1965
Application for plugging approved Sept 28 1965
Plugging commenced OCT-23 1965
Plugging completed OCT-27 1965
Reason for abandonment of well or producing formation _____

If a producing well is abandoned, date of last production _____ 19____
Was permission obtained from the Conservation Division or its agents before plugging was commenced? Yes

Name of Conservation Agent who supervised plugging of this well Archie Fleming
Producing formation _____ Depth to top _____ Bottom _____ Total Depth of Well 4602 Feet
Show depth and thickness of all water, oil and gas formations.

OIL, GAS OR WATER RECORDS


CASING RECORD

FORMATION	CONTENT	FROM	TO	SIZE	PUT IN	PULLED OUT
				8 5/8"	247	None
				4 1/2"	4601	4150

Describe in detail the manner in which the well was plugged, indicating where the mud fluid was placed and the method or methods used in introducing it into the hole. If cement or other plugs were used, state the character of same and depth placed, from _____ feet to _____ feet for each plug set.

Well Plugged - cement From 4602 - 4595 -
Plugged with cement From 4595 - 4560 -
Plugged with 35 dollar cement From 4560 - 4530 -
Ripped off 4 1/2" Pipe at 4150 and recovered
at 4150 feet

Backed hole down to 250 Build bridge with rocks
to 240. Then dump in 25 sacks of cement
Mud up to 20.5 foot Rock bridge to 30 foot
and 10 sacks of cement

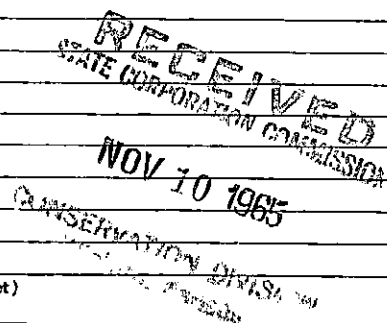

(If additional description is necessary, use BACK of this sheet)
Name of Plugging Contractor Clarke Corp.
Address Medicine Lodge Kansas

STATE OF Kansas, COUNTY OF Barber, ss.
owner (employee of owner) or (owner or operator) of the above-described

well, being first duly sworn on oath, says: That I have knowledge of the facts, statements, and matters herein contained and the log of the above-described well as filed and that the same are true and correct. So help me God.

(Signature) Clarke Corp. Lloyd L. Clarke, Pres.
Medicine Lodge, Kansas
(Address)

SUBSCRIBED AND SWORN to before me this 4th day of November, 1965
Judy M. Dine
Notary Public.

My commission expires November 16, 1968.