


Give All Information Completely
Make Required Affidavit
Mail or Deliver Report to:
Conservation Division
State Corporation Commission
212 No. Market
Wichita, Kansas

WELL PLUGGING RECORD

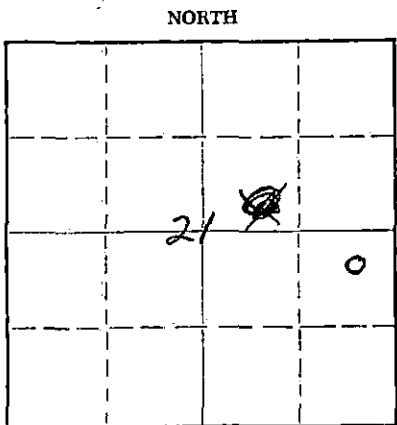

Barber County. Sec. 21 Twp. 34S Rge. 11E (E) (W)
Location as "NE/CNW/SW" or footage from lines NE SE
Lease Owner Charles Richard
Lease Name Laudis Well No. 1
Office Address 1st National Bank Building - OKC City OK.
Character of Well (completed as Oil, Gas or Dry Hole) Oil
Date well completed _____ 19____
Application for plugging filed 11-8 1966
Application for plugging approved 11-8 1966
Plugging commenced 11-8 1966
Plugging completed 11-14 - 11:00 1966
Reason for abandonment of well or producing formation non-commercial

If a producing well is abandoned, date of last production Jan. 1966
Was permission obtained from the Conservation Division or its agents before plugging was commenced? yes

Name of Conservation Agent who supervised plugging of this well A. Elving
Producing formation M155 Depth to top 4607 Bottom 4636 Total Depth of Well 4650 Feet
Show depth and thickness of all water, oil and gas formations.

OIL, GAS OR WATER RECORDS				CASING RECORD		
FORMATION	CONTENT	FROM	TO	SIZE	PUT IN	PULLED OUT
<u>Miss. Chert</u>	<u>oil & gas</u>	<u>4607</u>	<u>4636</u>	<u>8 5/8</u>	<u>271</u>	<u>NO</u>
				<u>4 1/2</u>	<u>4606</u>	<u>4207.23</u>
RECEIVED NOV 27 1966 CONSERVATION DIVISION						

Describe in detail the manner in which the well was plugged, indicating where the mud fluid was placed and the method or methods used in introducing it into the hole. If cement or other plugs were used, state the character of same and depth placed, from _____ feet to _____ feet for each plug set.

Dump chert and plug of bottom From 4650 TO 4580
Dump 3 sacks of cement with Baker From 4580 TO 4230
Could not bail hole down so pushed plug to 250.
Then dumped 10 feet of rock - rock From 250 TO 240
Then dumped 4 sacks of cement with Baker From 240 TO 220.
W.O.C. 48 hrs - Then bailed hole dry O.K.
Dumped 21 sacks of cement From 220 TO 165
And From 165 TO 40
Dump 10 feet of rock From 40 TO 30
Dump 10 sacks of cement From 30 TO Top
Well plugged.

(If additional description is necessary, use BACK of this sheet.)
Name of Plugging Contractor CHARIE CORPORATION
Address Box 187 Madelon Lodge Kansas

STATE OF Oklahoma, COUNTY OF Oklahoma, ss.
Charles J. Bernard (employee of owner) or (owner or operator) of the above-described well, being first duly sworn on oath, says: That I have knowledge of the facts, statements, and matters herein contained and the log of the above-described well as filed and that the same are true and correct. So help me God.

(Signature) Charles J. Bernard
1329 1st Natl Bldg - O.C.
(Address)

SUBSCRIBED AND SWORN TO before me this 18th day of November, 1966

My commission expires June 8, 1969
Barbara H. Luptiner Notary Public.

WELL LOG

Oklahoma City, Okla.

Operator Roy D. McAninch-1363 First Natl Bldg- 7
 Comm Dec. 1, 1964 Comp Dec. 17, 1964
 Shot _____ Qts. From _____ ft. To _____ ft.
 Acidized _____ Gal. _____
 Prod. Formation _____
 Initial Prod. _____
 Elevation _____

Lease Landis Well No. 1
 Loc C NE SE Sec 21 Twp 34S Rge 11W
 County Barber State Kansas
 Contractor Wilson Drilling Co.

Casing Record

Size	Ft.	Pulled	Remarks
8 5/8	267'	cemented w/	200 sxs 3%
4 1/2	4621'	cemented w/	75 sxs cement

FIGURES INDICATE BOTTOM OF FORMATION

Elevation- 1325 R.B.

- 30' - Sand
- 1600' - Shale & Sand
- 1703' - Shale & Lime
- 2250' - Lime
- 2865' - Shale & Lime
- 3350' - Lime
- 3662' - Shale & Lime
- 3920' - Shale
- 4130' - Shale & Lime
- 4262' - Shale
- 4556' - Lime
- 4607' - Lime & Shale
- 4622' - Chat

RECEIVED
 CONSERVATION COMMISSION
 DEC 19 1966
 CONSERVATION DIVISION
 Topeka, Kansas

This is to certify the above log is true and correct.

WILSON DRILLING COMPANY

BY Orlan N. Wilson
 Orlan N. Wilson

Subscribed and sworn to before me this 21 day of December, 1964.

My Commission expires:

November 29, 1966

Harold C. Kempf
 Notary Public