

15-007-00142-0000


STATE OF KANSAS
STATE CORPORATION COMMISSION

WELL PLUGGING RECORD

Give All Information Completely
Make Required Affidavit
Mail or Deliver Report to:
Conservation Division
State Corporation Commission
800 Bittling Building
Wichita, Kansas

Barber County, Sec. 32 Twp 34 Rge. 11 (E) W (W)
Location as "NE/CNW $\frac{1}{4}$ /SW $\frac{1}{4}$ " or footage from lines NW NW SW
Lease Owner Aurora Gasoline Company
Lease Name Goldman Well No. 1
Office Address 802 Union National Bank Bldg., Wichita, Kansas
Character of Well (completed as Oil, Gas or Dry Hole) Dry
Date well completed 5-30 1955
Application for plugging filed " 19
Application for plugging approved " 19
Plugging commenced " 19
Plugging completed " 19
Reason for abandonment of well or producing formation Dry hole

NORTH

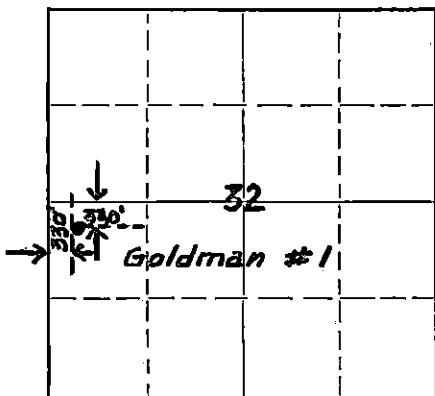

Locate well correctly on above
Section Plat

If a producing well is abandoned, date of last production 19
Was permission obtained from the Conservation Division or its agents before plugging was commenced? yes

Name of Conservation Agent who supervised plugging of this well M. A. RIVES
Producing formation Depth to top Bottom Total Depth of Well 5415 Feet
Show depth and thickness of all water, oil and gas formations.

OIL, GAS OR WATER RECORDS

CASING RECORD

Formation	Content	From	To	Size	Put In	Pulled Out
				8-5/8"	292'	None

Describe in detail the manner in which the well was plugged, indicating where the mud fluid was placed and the method or methods used in introducing it into the hole. If cement or other plugs were used, state the character of same and depth placed, from feet to feet for each plug set.

Set bottom plug at 285' with 1/3 sack hulls and 20 sacks cement.

Set top plug at 35' with 1/3 sack hulls and 10 sacks cement.

(If additional description is necessary, use BACK of this sheet)

Name of Plugging Contractor Barbour Drilling Company
Address 1612 First National Building,
Tulsa 3, Oklahoma.

STATE OF Oklahoma, COUNTY OF Tulsa, ss.
A. M. Barbour, Jr. (employee of owner) or (owner or operator) of the above-described well,
being first duly sworn on oath, says: That I have knowledge of the facts, statements, and matters herein contained and the log of the above-described well as filed and that the same are true and correct. So help me God. BARBOUR DRILLING COMPANY

(Signature) *A. M. Barbour, Jr.*

1612 First National Building
Tulsa, 3, (Address) Oklahoma

SUBSCRIBED AND SWORN to before me this 9th day of June, 1955

Merry Jane Burt
Notary Public.

My commission expires July 27, 1957

23-8390-s 6-51-20M

PLUGGING
FILE SEC 32 T 34 R 11 W
BOOK PAGE 123 LINE 31

15-007-00142-0000

RECEIVED

JUN 6 1955

GOLDMAN NO. 1

NW NW SW Section 32-34S-11W
Barber County, Kansas
Aurora Gasoline Company

AURORA-TULSA, OKLAHOMA

8-5/8" O. D. casing cemented at 293'

Drilling commenced May 8, 1955
Drilling completed May 30, 1955

FROM	TO	FORMATION	REMARKS
0'	50'	Surface clay & shale	
50	150	Sand & shale	8-5/8" O. D. casing cemented with
150	600	Red bed	200 sacks common cement at 293'
600	1200	Shale	
1200	1295	Shale & shells	
1295	1360	Shale with streaks of anhydrite	
1360	1625	Shale & shells	
1625	1770	Anhydrite & shale	
1770	1815	Shale & shells	
1815	1835	Anhydrite	
1835	1980	Shale & shells	
1980	2005	Lime	
2005	2205	Shale & lime shells	
2205	2330	Shale, shells & lime	
2330	2505	Shale & shells	
2505	2770	Shale & lime	
2770	2930	Shale	
2930	3127	Shale & lime	
3127	3290	Broken lime & shale	
3290	3380	Lime	
3380	3455	Shale & lime	
3455	3520	Shale	
3520	3566	Shale & lime	
3566	3645	Sand	
3645	3715	Sand & shale	
3715	3780	Shale & lime	
3780	3895	Lime	
3895	3965	Shale	
3965	4020	Shale & lime	
4020	4189	Lime	
4189	4280	Shale	
4280	4707	Lime	
4707	4727	Chert & lime	
4727	4729	Lime & chert	
4729	4745	Cherty lime	
4745	4779	Lime	
4779	4855	Chert & lime	
4855	4895	Lime	
4895	4932	Shale, lime & chert	
4932	5030	Lime	

RECEIVED
STATE

PLUGGING
WELL SEC 32 T 34 R 11W
BOOK PAGE 123 LINE 31

FROM	TO	FORMATION	REMARKS
5030	5040	Shale & lime	
5040	5052	Lime, shale & sand	
5052	5070	Shale & sand	
5070	5108	Lime & shale	
5108	5193	Lime	
5193	5230	Lime & sand	
5230	5250	Lime & shale	
5250	5285	Lime, sand & shale	
5285	5355	Lime	
5355	5375	Sand, shale & lime	
5375	5415	Lime	Dry hole - well plugged
T.D.	5415'		

This is a true copy of the driller's log as shown on the drilling tickets.

BARBOUR DRILLING COMPANY

By: A. W. Barbour Jr

Subscribed and sworn to before me on this 3rd day of June, 1955.

Merry Jane Burt
Notary Public

My commission expires: July 27, 1957