


STATE OF KANSAS
STATE CORPORATION COMMISSION

Form CP-4

Give All Information Completely
Make Required Affidavit
Mail or Deliver Report to:
Conservation Division
State Corporation Commission
212 No. Market
Wichita, Kansas 67202

WELL PLUGGING RECORD

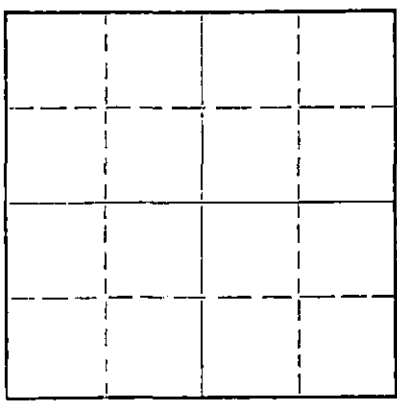

Locate well correctly on above Section Plat

BARBER County. Sec. 1 Twp. 34S Rge. (E) 13 (W)
Location as "NE/CNW%SW%" or footage from lines NW SE SW
Lease Owner SANTA-FE PIPE & SUPPLY, INC.
Lease Name R. H. DONOVAN Well No. 1
Office Address BOX 562 - GREAT BEND, KANSAS
Character of Well (completed as Oil, Gas or Dry Hole) GAS
Date well completed _____ 19____
Application for plugging filed APRIL 21 19 70
Application for plugging approved APRIL 22 19 70
Plugging commenced APRIL 22 19 70
Plugging completed APRIL 29 19 70
Reason for abandonment of well or producing formation DEPLETED

If a producing well is abandoned, date of last production _____ 19____
Was permission obtained from the Conservation Division or its agents before plugging was commenced? YES

Name of Conservation Agent who supervised plugging of this well RUSSELL BIBERSTEIN
Producing formation _____ Depth to top _____ Bottom _____ Total Depth of Well 4780 Feet
Show depth and thickness of all water, oil and gas formations.

OIL, GAS OR WATER RECORDS

CASING RECORD

FORMATION	CONTENT	FROM	TO	SIZE	PUT IN	PULLED OUT
				8 5/8"	418'	NONE
				5 1/2"	4780'	3703.83'

Describe in detail the manner in which the well was plugged, indicating where the mud fluid was placed and the method or methods used in introducing it into the hole. If cement or other plugs were used, state the character of same and depth placed, from _____ feet to _____ feet for each plug set.

4780' - 4746' - PLUG
 4746' - 4680' - SAND
 4680' - 4640' - 5 SACKS CEMENT
 4640' - 275' - MUD
 275' - 265' - ROCK BRIDGE
 265' - BASE - 4 1/2 YARDS READY MIX CONCRETE

RECEIVED
STATE CORPORATION COMMISSION
JUN 18 1970
CONSERVATION DIVISION
Wichita, Kansas

(If additional description is necessary, use BACK of this sheet)
Name of Plugging Contractor SANTA-FE PIPE & SUPPLY, INC.
Address BOX 562 - GREAT BEND, KANSAS

STATE OF KANSAS, COUNTY OF BARTON, SS.
T. L. NUTT (~~employee of owner~~) or (owner or operator) of the above-described

well, being first duly sworn on oath, says: That I have knowledge of the facts, statements, and matters herein contained and the log of the above-described well as filed and that the same are true and correct. So help me God.

(Signature) [Signature]

BOX 562 - GREAT BEND, KANSAS
(Address)

SUBSCRIBED AND SWORN to before me this 17th day of June, 19 70

My commission expires JULY 31, 1970

Mary M. Guesnier
Mary M. Guesnier
Notary Public.


WELL LOG BUREAU—KANSAS GEOLOGICAL SOCIETY
 508 East Murdock, Wichita, Kansas

Company. SKELLY OIL CO.
 Farm. R. H. Donovan No. 1

SEC. 1 T. 34 R. 13W
 NW SE SW
 990' fr EL, 990' fr SL, SW/4

Total Depth. 4780 PBD 4746
 Comm. 2-5-56 Comp. 2-22-56
 Shot or Treated. 250 gal acid 4718-33: Vis-O-Frac 4718-33 &
 Contractor. Chas. Hulme Drilling Co., Inc. 4690-4712
 Issued. 5-5-56

County Barber
 KANSAS

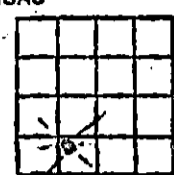

8 5/8 @ CASING: 418' w/ 250 sx cmt.
 5 1/2 @ 4780' w/ 200 sx cmt.

Elevation. 1585 DF
 Production. 4,977,000 CFGPD

Figures Indicate Bottom of Formations.

surface soil & clay	100
clay & shells	418
shale & shells	1100
shale & lime	1685
shale	1710
lime	2020
lime & shale	2080
lime	2475
shale & lime	2760
shale	3135
lime & shale	3480
shale	3550
shale & sand	3820
lime & shale	4000
lime	4690
white tripolitic & white clear translucent chert	4720
white opaque & tripolitic chert	4750
lime	4780
Total Depth	
Plugged back to	4746
TOPS:	
Elgin sand	3620
Heebner	3829
Lansing	4023
Base K. C.	4546
Marmaton lime	4560
Mississippi lime	4688

Perf. 131/4690-4712, 90/4718-33

Producing Formation: Mississippi lime 4690-4712 & 4718-33.

DST #1: packer @ 4680, 40' anchor, open 1 hr. good bl. air immed. gas to surf. 4 min, too small to meas. rec. 55' drlg. mud, IFP 35#, FFP 42#, BHP 1614#/20 min.

DST #2: packer @ 4720, 30' anchor, open 1 hr. gas to surf. 2 min. ga. 1700 MCFGPD, rec. 45' drlg. mud, IFP 225#, FFP 225#, BHP 1625#/20 min.

Ran Schlumberger Survey

RECEIVED
 STATE CORPORATION COMMISSION
 APR 22 1970
 CONSERVATION DIVISION
 Wichita, Kansas

APR 21 1970