


STATE OF KANSAS  
STATE CORPORATION COMMISSION

WELL PLUGGING RECORD

Give All Information Completely  
Make Required Affidavit  
Mail or Deliver Report to  
Conservation Division  
State Corporation Comm.  
245 North Water  
Wichita, KS 67202

Barber County. Sec. 1 Twp. 34 Rge. 13W E/W  
Location as "NE/CNW $\frac{1}{4}$ SW $\frac{1}{4}$ " or footage from lines \_\_\_\_\_  
C NE SE  
Lease Owner North American Drlg. & Exp.  
Lease Name Donivan Well No. 1  
Office Address 3420 West Tenth Great Bend Kas. 67530  
Character of Well (Completed as Oil, Gas or Dry Hole) \_\_\_\_\_

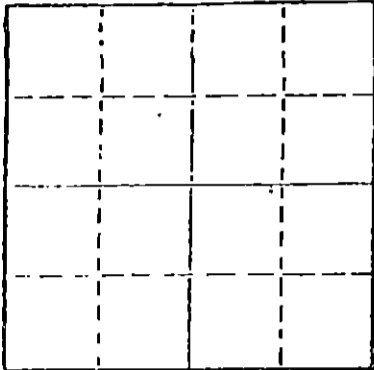

Locate well correctly on above  
Section Plat

Dry hole  
Date Well completed 6/ 1978  
Application for plugging filed 12/1/78 1978  
Application for plugging approved 12/5/ 1978  
Plugging commenced 12/22/ 1978  
Plugging completed 12/29 1978

Reason for abandonment of well or producing formation \_\_\_\_\_  
dry  
If a producing well is abandoned, date of last production \_\_\_\_\_  
none 19\_\_\_\_

Was permission obtained from the Conservation Division or  
its agents before plugging was commenced? yes

Name of Conservation Agent who supervised plugging of this well Wm T Owen  
Producing formation Miss. Depth to top \_\_\_\_\_ Bottom \_\_\_\_\_ Total Depth of Well 4648  
Show depth and thickness of all water, oil and gas formations.

OIL, GAS OR WATER RECORDS

CASING RECORD

FORMATION	CONTENT	FROM	TO	SIZE	PUT IN	PULLED OUT
	Surface	0	355	8 5/8		
		0	4634	5 1/2		2724

Describe in detail the manner in which the well was plugged, indicating where the mud fluid  
was placed and the method or methods used in introducing it into the hold. If cement or other  
plugs were used, state the character of same and depth placed, from \_\_\_\_\_ feet to  
\_\_\_\_\_ feet for each plug set.

Bridge at 3558' fill hole with sand to 3530' dump 5 sx. cement

Pumped top with Allied cementers 5 sx. hulls 20 sx Jell and  
126 sx. 60-40 pozmix cemeht 3% C.C.

RECEIVED  
STATE CORPORATION COMMISSION

JAN - 5 1979 1-3-79

CONSERVATION DIVISION

(If additional description is necessary, use BACK of this sheet)

Name of Plugging Contractor \_\_\_\_\_

STATE OF Kansas COUNTY OF Rice, ss.  
(employee of owner) or (owner or operator)

of the above-described well, being first duly sworn on oath, says: That I have knowledge of  
the facts, statements, and matters herein contained and the log of the above-described well  
as filed and that the same are true and correct. So help me God.

(Signature) G. A. Nicholas

(Address)

SUBSCRIBED AND SWORN TO before me this 2nd day of January, 1979

Julia A. Waggoner  
Notary Public.

My commission expires April 29, 1980

