


STATE OF KANSAS  
STATE CORPORATION COMMISSION

WELL PLUGGING RECORD

Give All Information Completely  
Make Required Affidavit  
Mail or Deliver Report to  
Conservation Division  
State Corporation Comm.  
245 North Water  
Wichita, KS 67202

Barber County, Sec. 1 Twp. 34S Rge. 13W EXW  
Location as "NE/CNW $\frac{1}{4}$ SW $\frac{1}{4}$ " or footage from lines CN SE NE

Lease Owner Petroleum Technical Services Co.  
Lease Name RH Donovan Well No. 3  
Office Address 3000 N. Garfield, Suite 1000, Midland, TX 79701  
Character of Well (Completed as Oil, Gas or Dry Hole) Dry Hole

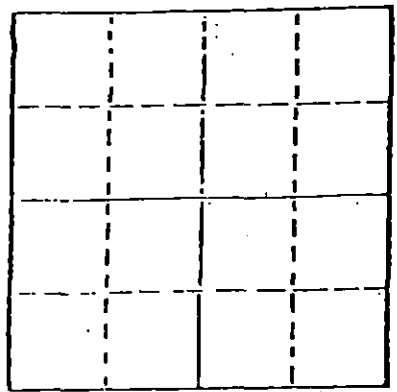

Locate well correctly on above Section Plot

Date Well completed 7-6-1982  
Application for plugging filed 7-6-1982  
Application for plugging approved 7-6-1982  
Plugging commenced 7-6-1982  
Plugging completed 7-6-1982  
Reason for abandonment of well or producing formation Dry Hole

If a producing well is abandoned, date of last production 19

Was permission obtained from the Conservation Division or its agents before plugging was commenced? Yes

Name of Conservation Agent who supervised plugging of this well Maurice Leslie  
Producing formation \_\_\_\_\_ Depth to top \_\_\_\_\_ Bottom \_\_\_\_\_ Total Depth of Well \_\_\_\_\_  
Show depth and thickness of all water, oil and gas formations.

OIL, GAS OR WATER RECORDS

CASING RECORD

FORMATION	CONTENT	FROM	TO	SIZE	PUT IN	PULLED OUT
				8 5/8	495'	

Describe in detail the manner in which the well was plugged, indicating where the mud fluid was placed and the method or methods used in introducing it into the hold. If cement or other plugs were used, state the character of same and depth placed, from \_\_\_\_\_ feet to \_\_\_\_\_ feet for each plug-set.

- 60 sacks @ 1250'
- 40 sacks @ 485'
- 10 sacks @ 40'
- 10 sacks in mouse hole
- 5 sacks in rat hole

(If additional description is necessary, use BACK of this sheet)

Name of Plugging Contractor \_\_\_\_\_

STATE OF Kansas COUNTY OF Sedgwick, ss.  
Robert L. Eisel (employee of owner) or (owner or operator)

of the above-described well, being first duly sworn on oath, says: That I have knowledge of the facts, statements, and matters herein contained and the log of the above-described well as filed and that the same are true and correct. So help me God.

(Signature) Robert L. Eisel  
P.O. Box 8609, Wichita, KS 67208  
(Address)

SUBSCRIBED AND SWORN TO before me this 20th day of July, 1982

Tiffany S. Little Notary Public.

My commission expires 8-11-85



RECEIVED  
STATE CORPORATION COMMISSION  
JUL 22 1982  
CONSERVATION DIVISION  
Wichita, Kansas

DRILLER'S LOG

RECEIVED  
STATE CORPORATION COMMISSION

JUL 22 1982

CONSERVATION DIVISION  
Wichita, Kansas

Operator: Petroleum Technical Services  
Lease Name: RH Donovan #3  
Spot Location: CN SE NE  
                  Sec. 1-34S-13W  
County, State: Barber, Kansas

Commenced: 6-25-82  
Completed: 7-06-82

Surface Casing: Ran 12 jts. new 24 lb. 8 5/8"  
casing. Set at 495' KB. Cemented with 400  
sacks Class H, 2% gel, 1/4 lb. flow seal, 3%  
cc.

FORMATION

DEPTH


<u>Clay &amp; Red Rock</u>	<u>0-180</u>
<u>Sand</u>	<u>180-205</u>
<u>Red Bed</u>	<u>205-395</u>
<u>Red Bed &amp; Shale</u>	<u>395-1479</u>
<u>Shale &amp; Shells</u>	<u>1479-2140</u>
<u>Shale &amp; Lime</u>	<u>2140-3850</u>
<u>Lime &amp; Shale</u>	<u>3850-4040</u>
<u>Lime</u>	<u>4040-4125</u>
<u>Lime &amp; Shale</u>	<u>4125-4435</u>
<u>Lime</u>	<u>4435-4555</u>
<u>Lime &amp; Shale</u>	<u>4555-4643</u>
<u>Lime</u>	<u>4643-5040</u>
<u>R.T.D.</u>	<u>5040</u>

I do hereby certify that the foregoing statements are true and correct to the best of my knowledge and belief.

EAGLE DRILLING, INC.

*Robert L. Eisel*

Robert L. Eisel  
Vice-President

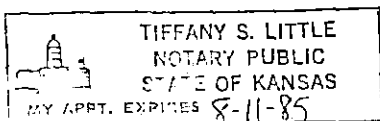

STATE OF KANSAS        )  
COUNTY OF SEDGWICK ) ss:

Subscribed and sworn to before me this 20th day of July, 1982.

My appointment expires: 8-11-85

*Tiffany S. Little*  
Notary Public      Tiffany S. Little