


WELL PLUGGING RECORD

Give All Information Completely  
Make Required Affidavit  
Mail or Deliver Report to:  
Conservation Division  
State Corporation Commission  
800 Bittling Building  
Wichita, Kansas

NORTH

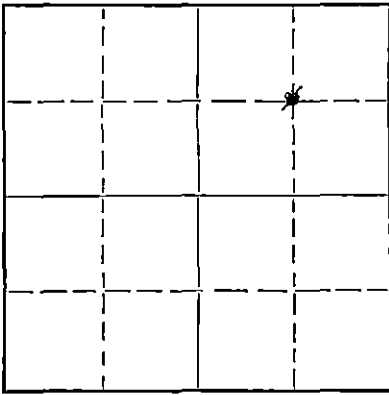

Locate well correctly on above  
Section Plat

Pratt County, Sec. 1 Twp. 28 Rge. (E) 11 (W)

Location as "NE/CNW $\frac{1}{4}$ SW $\frac{1}{4}$ " or footage from lines NE/4, 1340' fm Nth & East lines

Lease Owner Sinclair Oil & Gas Co

Lease Name Frank F. Allbritten Well No. 1

Office Address Box 521, Tulsa, Okla.

Character of Well (completed as Oil, Gas or Dry Hole) Gas Well

Date well completed Sept. 2 1952

Application for plugging filed Nov. 3 1952

Application for plugging approved Nov. 6 1952

Plugging commenced Nov 10 1952

Plugging completed Nov 18 1952

Reason for abandonment of well or producing formation Production depleted

If a producing well is abandoned, date of last production August 19 52

Was permission obtained from the Conservation Division or its agents before plugging was commenced? yes

Name of Conservation Agent who supervised plugging of this well M.A. Rives

Producing formation Viola Lime Depth to top 4156 Bottom 4170 Total Depth of Well 4170 Feet

Show depth and thickness of all water, oil and gas formations.

OIL, GAS OR WATER RECORDS

CASING RECORD

Formation	Content	From	To	Size	Put In	Pulled Out
<u>Viola Lime</u>	<u>Dry</u>	<u>4156</u>	<u>4170</u>	<u>13"</u> <u>7"</u>	<u>331</u> <u>4201'</u>	<u>0</u> <u>2600'</u>

Describe in detail the manner in which the well was plugged, indicating where the mud fluid was placed and the method or methods used in introducing it into the hole. If cement or other plugs were used, state the character of same and depth placed, from \_\_\_\_\_ feet to \_\_\_\_\_ feet for each plug set.

- 4170 - 4140' Sand
- 4140 - 4110' Cement 6 sx
- 4110 - 1000' Mud
- 1000 - 980' Mud (Weight mud) & 3 sx Jel.
- 980 - 300' Mud
- 300' - Rock Bridge
- 300 - 290' Mud
- 290 - 265' Cement 25 sx
- 265 - 40' Mud
- 40 - Rock Bridge
- 40 - 0 Cement 10sx

(If additional description is necessary, use BACK of this sheet)

Correspondence regarding this well should be addressed to Mr E.H. Gibbons

Address Box 551 Chase, Kans

STATE OF Kansas, COUNTY OF Rice, ss.

E.H. Gibbons (employee of owner) or (owner/proprietor) of the above-described well,

being first duly sworn on oath, says: That I have knowledge of the facts, statements, and matters herein contained and the log of the above-described well as filed and that the same are true and correct. So help me God.

(Signature) E.H. Gibbons

Box 551 Chase, Kans

(Address)

SUBSCRIBED AND SWORN to before me this 22nd day of November, 1952

Frank F. Allbritten  
Notary Public.

My commission expires August 22, 1953

23-5091-S 8-50-10M

**PLUGGING**  
FILE SEC 1 T 28 R 112  
BOOK PAGE 57 LINE 5

RECEIVED  
STATE CORPORATION COMMISSION  
NOV 24 1952  
11-24-52  
CONSERVATION DIVISION  
Wichita, Kansas

Well Log  
Sinclair Oil & Gas Co

Frank F. Allbritten #1  
NE/4, 1-28S-11W, Pratt Co., Kans  
1340' fm Nth & East lines

Drilling Begun Aug. 7, 1939  
Drilling completed Sept. 2, 1939  
T.D. 4170' Viola Lime  
28,500,000 cu ft gas

Drillers Log

Clay & Sand	230'
Red Rock & Shells	447
Lime & Shells	460
Shale & Lime	775
Anhydrite & Shale	935
Lime-Shells	1036
Salt & Shells	1165
Lime	1295
Lime & Shale	1495
Broken Lime & Shale	1795
Lime & Sand	1893
Broken Lime & Shale	2225
Lime & Shale	2735
Broken Lime & Shale	2800
Shale & Lime	3033
Lime	3325
Broken Lime	3350
Shale	3430
Lime	3490
Shale (top K.C. 3525)	3530
Lime	3938
Lime & Shale	3988
Lime	4014
Shale & Lime	4096
Shale (top Viola 4156 $\frac{1}{2}$ ')	4156
Lime	4170 TD

13" set @ 331' w/350 sx cement  
7" set @ 4159' w/300 sx "

oil show 3525-35'  
" 3570-75'

SINCLAIR OIL & GAS CO  
PRATT, KANSAS

**PLUGGING**  
FILE SEC 1 T 28 R 1134  
BOOK PAGE 57 LINE 5