


STATE OF KANSAS
STATE CORPORATION COMMISSION

Form CP-4

Give All Information Completely
Make Required Affidavit
Mail or Deliver Report to:
Conservation Division
State Corporation Commission
212 No. Market
Wichita, Kansas 67202

WELL PLUGGING RECORD

Rush County, Sec. 34 Twp. 18S Rge. XXX 20 (W)
Location as "NE/CNW/SW" or footage from lines N/2 NE SE
Lease Owner Pickrell Drilling Company
Lease Name Bott "C" Well No. 2
Office Address 705 Fourth National Bank Bldg., Wichita, Kansas
Character of Well (completed as Oil, Gas or Dry Hole) Dry Hole
Date well completed December 3 19 70
Application for plugging filed December 3 19 70
Application for plugging approved December 3 19 70
Plugging commenced December 3 19 70
Plugging completed December 3 19 70
Reason for abandonment of well or producing formation Dry Hole

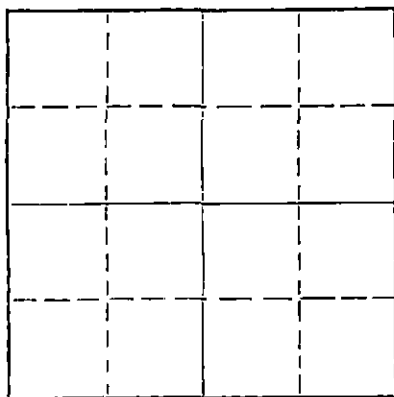

Locate well correctly on above
Section Flat

If a producing well is abandoned, date of last production 19
Was permission obtained from the Conservation Division or its agents before plugging was commenced? Yes

Name of Conservation Agent who supervised plugging of this well Leo Massey
Producing formation _____ Depth to top _____ Bottom _____ Total Depth of Well 4240 Feet
Show depth and thickness of all water, oil and gas formations.

OIL, GAS OR WATER RECORDS

CASING RECORD

FORMATION	CONTENT	FROM	TO	SIZE	PUT IN	PULLED OUT
				8-5/8"	277'	None

Describe in detail the manner in which the well was plugged, indicating where the mud fluid was placed and the method or methods used in introducing it into the hole. If cement or other plugs were used, state the character of same and depth placed, from _____ feet to _____ feet for each plug set.

Bottom Plug @ 540' w/70 sacks cement, Plug @ 240' w/20 sacks cement,
Top Plug @ 40' w/10 sacks cement.


RECEIVED
STATE CORPORATION COMMISSION
DEC 9 - 1970
CONSERVATION DIVISION
Wichita, Kansas

(If additional description is necessary, use BACK of this sheet)

Name of Plugging Contractor Pickrell Drilling Company
Address 705 Fourth National Bank Building, Wichita, Kansas 67202

STATE OF Kansas, COUNTY OF Sedgwick, ss.
C. W. Sebitts (employee of owner) or (owner or operator) of the above-described well, being first duly sworn on oath, says: That I have knowledge of the facts, statements and matters herein contained and the log of the above-described well as filed and that the same are true and correct. So help me God.

(Signature) C. W. Sebitts
705 Fourth National Bank Bldg., Wichita, Kansas
(Address)

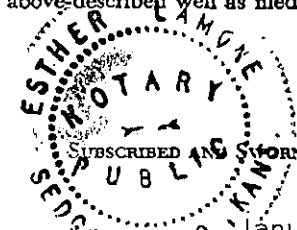

SUBSCRIBED AND SWORN to before me this 7th day of December, 19 70
Esther Lamone
My commission expires 20 January 19, 1973
Esther Lamone Notary Public.

ROTARY DRILLING LOG

COMPANY: Pickrell Drilling Company
705 Fourth National Bank Bldg.
Wichita, Kansas 67202

Rotary Drilling Commenced 11/25/70

Rotary Drilling Completed 12/3/70

LOCATION: Bott "C" No. 2, N/2 NE SE Sec. 34-18S-20W
Rush County, Kansas

CONTRACTOR: **PICKRELL DRILLING COMPANY**
Wichita, Kansas

CASING RECORD: Run 13 Jts. 8-5/8" surface casing set @ 277' KB. Cemented with
150 Sacks cement. Completed 8:30 P.M. Circulated.

No oil string run. D & A, Plugged 4:00 P.M. December 3, 1970.

LOG

(Figures indicate bottom of formation — measurements from top of rotary bushing.)

40	Clay - Post Rock	C.F.S.
277	Shale & Shells	4122
795	Shale	4140
1005	Sand	4240
1383	Shale & Sand Stringers	
1413	Anhydrite	
1530	Shale	
2440	Shale & Lime	S.L.M.
2750	Lime	Board 3989.39
3465	Shale & Lime	Strap 3987.89
3710	Shale	1.50 Difference
3795	Lime & Shale	
3900	Shale & Lime	
4140	Lime	Slope Tests
4240	Sand Lime & Shale, RTD	2000
		2500
		3000
		3500
		4000

RECEIVED
STATE CORPORATION COMMISSION
DEC 9 - 1970
CONSERVATION DIVISION
Wichita, Kansas

The undersigned, C. W. Sebitts, Attorney-in-Fact for PICKRELL DRILLING COMPANY, hereby certifies in behalf of said Company, that the above is a true and correct log of the formation encountered in drilling the above well as reflected by the Daily Drilling Reports.

PICKRELL DRILLING COMPANY
[Signature]
By C. W. Sebitts Attorney-in-Fact

STATE OF KANSAS }
COUNTY OF SEDGWICK } ss.:

On this 7th day of December, 19 70, before me the undersigned, a Notary Public, in and for the County and State aforesaid, personally appeared C. W. Sebitts, to me known to be the identical person who subscribed the name of PICKRELL DRILLING COMPANY to the foregoing instrument as its Attorney-in-Fact and acknowledged to me that he executed the same as his free and voluntary act and deed, and as the free and voluntary act and deed of such company, for the uses and purposes therein set forth.

Given under my hand and seal of office the day and year last above written.

My commission expires: January 19, 1973

[Signature]
Esther Lamone
Notary Public

