


Give All Information Completely
Make Required Affidavit
Mail or Deliver Report to:
Conservation Division
State Corporation Commission
211 No. Broadway
Wichita, Kansas

WELL PLUGGING RECORD

15-151-10988-60.00

NORTH

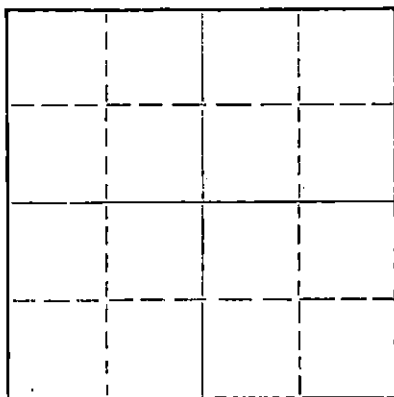

Locate well correctly on above
Section Plat

Pratt

County. Sec. 23 Twp. 27 Rgs. (E) 15 (W)

Location as "NE/CNW/SW" or footage from lines SW/4 SW/4 SW/4

Lease Owner Braden Drilling, Inc.

Lease Name Irwin Well No. 2

Office Address L206 Union National Bldg., Wichita, Kansas

Character of Well (completed as Oil, Gas or Dry Hole) Dry Hole

Date well completed May 15 19 62

Application for plugging filed May 15 19 62

Application for plugging approved May 15 19 62

Plugging commenced May 15 19 62

Plugging completed May 16 19 62

Reason for abandonment of well or producing formation

If a producing well is abandoned, date of last production 19

Was permission obtained from the Conservation Division or its agents before plugging was commenced? yes

Name of Conservation Agent who supervised plugging of this well Fred W. Hampel

Producing formation Depth to top Bottom Total Depth of Well 4605 Feet

Show depth and thickness of all water, oil and gas formations.

OIL, GAS OR WATER RECORDS

CASING RECORD

FORMATION	CONTENT	FROM	TO	SIZE	PUT IN	PULLED OUT
		0	292	8 5/8	292	none

Describe in detail the manner in which the well was plugged, indicating where the mud fluid was placed and the method or methods used in introducing it into the hole. If cement or other plugs were used, state the character of same and depth placed, from feet to feet for each plug set.

Plug at 275' with 20 sacks of cement. Filled hole with heavy drilling mud. Set top plug at 35' with 10 sacks of cement.

RECEIVED
STATE CORPORATION COMMISSION

MAY 22 1962 OS-22-62

CONSERVATION DIVISION
Wichita, Kansas

(If additional description is necessary, use BACK of this sheet)

Name of Plugging Contractor Braden Drilling, Inc.

Address 1206 Union National Bldg., Wichita, Kansas

STATE OF Kansas, COUNTY OF Sedgwick, ss.

F. M. Callaway (employee of owner) or (owner or operator) of the above-described well, being first duly sworn on oath, says: That I have knowledge of the facts, statements, and matters herein contained and the log of the above-described well as filed and that the same are true and correct. So help me God.

(Signature) F. M. Callaway

1206 Union National Bldg., Wichita, Kansas
(Address)

SUBSCRIBED AND SWORN to before me this 17 day of May, 1962

My commission expires March 21, 1966

Notary Public.

INVOICED

DATE 5/22/62

INV. NO. 5038-W