


STATE OF KANSAS  
STATE CORPORATION COMMISSION

## WELL PLUGGING RECORD

Give All Information Completely  
Make Required Affidavit  
Mail or Deliver Report to:  
Conservation Division  
State Corporation Commission  
211 No. Broadway  
Wichita, Kansas

NORTH

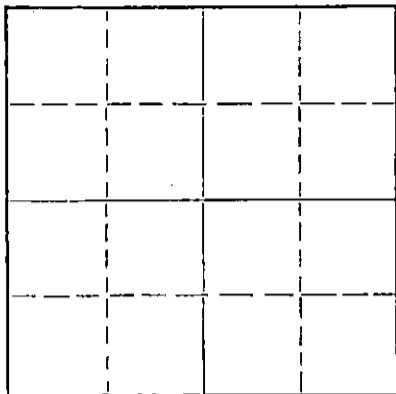

Locate well correctly on above  
Section Plot

Pratt

County. Sec. 28 Twp. 27 Rge. (E) 15 (W)

Location as "NE/CNW%SW%" or footage from lines NE/4 SW/4 NE/4

Lease Owner. Braden Drilling, Inc.

Lease Name. Heimuller

Well No. 1

Office Address. 1206 Union National Bldg., Wichita, Kansas

Character of Well (completed as Oil, Gas or Dry Hole) Hole was lost-rig skidded

Date well completed 19

Application for plugging filed June 4 19 61

Application for plugging approved June 4 19 61

Plugging commenced June 4 19 61

Plugging completed June 4 19 61

Reason for abandonment of well or producing formation Hole was lost and rig skidded to Heimuller 1-A 10' east

If a producing well is abandoned, date of last production 19

Was permission obtained from the Conservation Division or its agents before plugging was commenced? yes

Name of Conservation Agent who supervised plugging of this well Fred W. Hampel

Producing formation Depth to top Bottom Total Depth of Well 2660 Feet

Show depth and thickness of all water, oil and gas formations.

## OIL, GAS OR WATER RECORDS

## CASING RECORD

FORMATION	CONTENT	FROM	TO	SIZE	PUT IN	PULLED OUT
		0	300	8 5/8	300	none

Describe in detail the manner in which the well was plugged, indicating where the mud fluid was placed and the method or methods used in introducing it into the hole. If cement or other plugs were used, state the character of same and depth placed, from feet to feet for each plug set.

Hole filled with heavy mud. Plug at 240 ft and cemented with 20 sacks cement.

Plug at 30 ft and cemented with 10 sacks cement.

RECEIVED  
STATE CORPORATION COMMISSION

JUN 27 1961

06-27-61

CONSERVATION DIVISION  
Wichita, Kansas

(If additional description is necessary, use BACK of this sheet)

Name of Plugging Contractor Braden Drilling, Inc.

Address 1206 Union National Bldg., Wichita, Kansas

STATE OF Kansas, COUNTY OF Sedgwick, ss.

F. M. Callaway

(employee of owner) or (owner or operator) of the above-described

well, being first duly sworn on oath, says: That I have knowledge of the facts, statements, and matters herein contained and the log of the above-described well as filed and that the same are true and correct. So help me God.

(Signature)

1206 Union National Bldg., Wichita, Kansas

(Address)

SUBSCRIBED AND SWORN TO before me this 26 day of June, 19 61

My commission expires March 21, 1962

Notary Public.

INVOICED

DATE

6/29/61

INV. NO.

3350W

DRILLER'S LOG

Braden Drilling, Inc. et al  
HEIMULLER #1  
NE/4 SW/4 NE/4 Sec. 28-27-15W  
Pratt County, Kansas

Commenced: May 27, 1961

Completed: June 4, 1961

(hole lost and rig skidded  
10' east to Heimuller #1-A)

Set 8 5/8" at 300' and cemented  
with 300 sx Pozmix

Clay, sand and shale	300
Sand and shale	420
Red rock and shells	1020
Anhydrite	1030
Anhydrite and shale	1377
Shale and shells	2010
Shale and shells - Ft. Riley	2137
Lime	2452
Lime and shale	2660 Total Depth

I hereby certify that this is a true and correct log of the above captioned well, as shown by the daily drilling reports.

F. M. Callaway  
F. M. Callaway

Subscribed and sworn to before me this 26th day of June, 1961.

My commission expires March 21, 1962.

Helen Schultz  
Helen Schultz, Notary Public

RECEIVED  
STATE CORPORATION COMMISSION

JUN 27 1961