


# WELL PLUGGING RECORD

STATE OF KANSAS  
 STATE CORPORATION COMMISSION  
 Get All Information Completely  
 Make Required Affidavit  
 Mail or Deliver Report to:  
 Conservation Division  
 State Corporation Commission  
 800 Bittling Building  
 Wichita, Kansas

OR  
**FORMATION PLUGGING RECORD** Strike out upper line when reporting plugging of formations.

Sumner County. Sec. 14 Twp. 30 Rge. 1 (E) W (W)  
 Location as "NE $\frac{1}{4}$ NW $\frac{1}{4}$ SW $\frac{1}{4}$ " or footage from lines. (NW/4)NE/4 NE/4

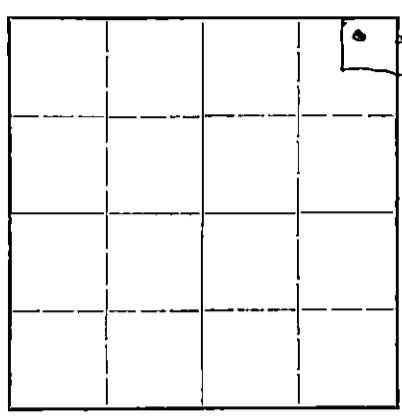

Locate well correctly on above Section Plat

Lease Owner M. J. Sullivan  
 Lease Name Williams Well No. 1  
 Office Address 302 Midland Bldg. Kansas City, Missouri  
 Character of Well (completed as Oil, Gas or Dry Hole) Oil  
 Date well completed..... 19.....  
 Application for plugging filed July 7, 19 47  
 Application for plugging approved July 7, 19 47  
 Plugging commenced July 9, 19 47  
 Plugging completed July 11, 19 47  
 Reason for abandonment of well or producing formation.....

If a producing well is abandoned, date of last production..... 19.....  
 Was permission obtained from the Conservation Division or its agents before plugging was commenced?.....


Name of Conservation Agent who supervised plugging of this well W. G. Buffington  
 Producing formation..... Depth to top..... Bottom..... Total Depth of Well 3850 Feet  
 Show depth and thickness of all water, oil and gas formations.

OIL, GAS OR WATER RECORDS CASING RECORD

Formation	Content	From	To	Size	Put In	Pulled Out
				5 $\frac{1}{2}$ -inch	3850'	2497'

Describe in detail the manner in which the well was plugged, indicating where the mud fluid was placed and the method or methods used in introducing it into the hole. If cement or other plugs were used, state the character of same and depth placed, from..... feet to..... feet for each plug set.

Set bridge at bottom of pipe at 3850'. Dumped 10 sacks cement. Put 20 sacks of cement at bottom of surface and 10 sacks at top.

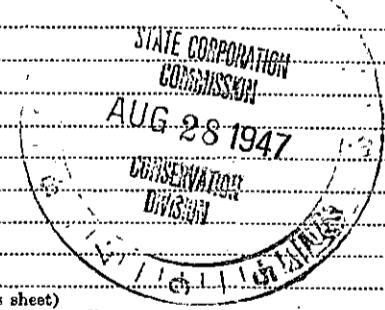

(If additional description is necessary, use BACK of this sheet)  
 Correspondence regarding this well should be addressed to Sterling Drilling Company  
 Address Sterling, Kansas

STATE OF Kansas, COUNTY OF Rice, ss.  
Rollin Mead (employee of owner) or (owner or operator) of the above-described well,

being first duly sworn on oath, says: That I have knowledge of the facts, statements, and matters herein contained and the log of the above-described well as filed and that the same are true and correct. So help me God.

(Signature) Rollin Mead  
Sterling, Kansas (Address)

SUBSCRIBED AND SWORN to before me this 16th day of August, 19 47  
[Signature] Notary Public.

My commission expires September 17, 1949.

31-871 9-45-6M  
**PLUGGING**  
 FILE SEC 14 T 30 R W  
 BOOK PAGE 118 LINE 43

Sterling Drilling

WELL LOG

Farm - Clara Williams No. 1 - Sec. 14, Twp. 30, R. 1 W. - C NE NE

Orig drilled by \* Sullivan et al  
(Coop Refs)

Total Depth - 3872½'

Comm. - 3-10-44 Comp. 5-11-44 County - Sumner, Kansas

Shot or Treated - 20 Qts.

Contractor - H. M. Williams (Rotary) J. S. McKnabb (Cable)

CASING;

10 3/4"

199'

5"

3856½'

Shale and sand	204
Shale and lime	400
Lime and Shale	830
Shale and Shells	990
Lime and shale	1160
Shale and shells	1605
Lime and shale	1635
Shale and shells	1770
Lime and shale	1950
Lime	2015
Lime and shale	2100
Lime	2260
Lime and shale	2510
Shale and shells	2600
Lime and shale	2845
Lime	2990
Lime and shale	3331
Shale and lime	3361
Lime and shale	3424
Miss. Chat	3439
Lime and shale	3447
Lime Miss.	3468
Lime and shale	3795
Lime wht.	3820
Shale blk	3852
Shale and lime, sh. oil	3856
Sand	3872½'
Total Depth.	

## Geological Tops:

Lansing - K. C.	2835
Miss. Lime	3425
Wilcox Sd.	3855

(This copy furnished by \* M. J. Sullivan  
302 Midland Building  
Kansas City 6, Missouri.)



**PLUGGING**  
FILE SEC 14 T 30 R 1 W  
BOOK PAGE 118 LINE 43