

R

STATE OF KANSAS
STATE CORPORATION COMMISSION

Form CP-4

WELL PLUGGING RECORD

Give All Information Completely
Make Required Affidavit
Mail or Deliver Report to:
Conservation Division
State Corporation Commission
211 No. Broadway
Wichita, Kansas

Morton County, Sec. 13 Twp. 33S Rge. 42 (W)

Location as "NE/CNW&SW" or footage from lines SW SE

Lease Owner Aikman Brothers Corporation

Lease Name Landrum Well No. 1

Office Address 706 Bank of the Southwest Building, Amarillo, Texas

Character of Well (completed as Oil, Gas or Dry Hole) Dry Hole

Date well completed December 1 19 68

Application for plugging filed November 30 19 68

Application for plugging approved November 30 19 68


Plugging commenced December 1 19 68

Plugging completed December 1 19 68

Reason for abandonment of well or producing formation Dry Hole

If a producing well is abandoned, date of last production None 19

Was permission obtained from the Conservation Division or its agents before plugging was commenced? Yes

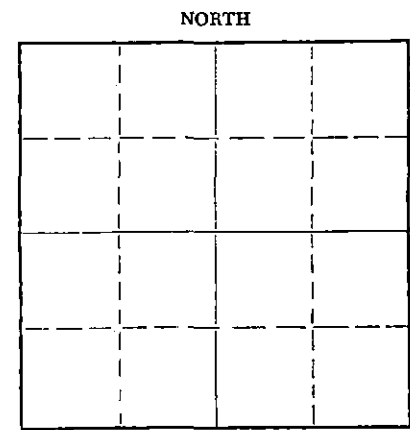

Locate well correctly on above Section Plat

Name of Conservation Agent who supervised plugging of this well Edgar J. Eves

Producing formation None Depth to top Bottom Total Depth of Well 5469 Feet

Show depth and thickness of all water, oil and gas formations.

OIL, GAS OR WATER RECORDS

CASING RECORD

FORMATION	CONTENT	FROM	TO	SIZE	PUT IN	PULLED OUT
		0	1480'	8 5/8"	1480'	None

Describe in detail the manner in which the well was plugged, indicating where the mud fluid was placed and the method or methods used in introducing it into the hole. If cement or other plugs were used, state the character of same and depth placed, from feet to feet for each plug set.

Gunned pits forming heavy mud - filled hole to 900', pushed plug to 900', cemented with 30 sacks cement, filled hole to 40', cemented with 15 sacks, completed @ 11:15 am 12-1-68.

RECEIVED
STATE CORPORATION COMMISSION
DEC 3 0 1968
CONSERVATION DIVISION
Wichita, Kansas

(If additional description is necessary, use BACK of this sheet)

Name of Plugging Contractor Garvey Drilling Company

Address Route 2, Great Bend, Kansas 67530

STATE OF Kansas COUNTY OF Barton, ss.

Emice J McEachern (employee of owner) or (owner or operator) of the above-described well, being first duly sworn on oath, says: That I have knowledge of the facts, statements, and matters herein contained and the log of the above-described well as filed and that the same are true and correct. So help me God.

(Signature) Emice J McEachern

Route 2, Great Bend, Kansas 67530

(Address)

SUBSCRIBED AND SWORN TO before me this 23 day of December, 19 68

My commission expires November 5th, 1969

Richard A. Deys Notary Public.

R

WELL LOG

COMPANY **Aikman Brothers Corporation**

SEC. 13 T. 33S R. 42W

FARM **Landrum** NO. **1**


LOC. **C SW SE**

TOTAL DEPTH **5469'**

COUNTY **Morton Co., Kansas**

COMM. **11-13-68** COMP. **12-1-68**

CONTRACTOR **Garvey Drilling Company**

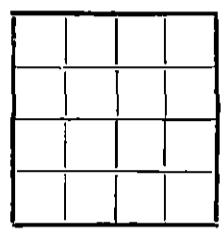

CASING **8 5/8" @ 1480' w/625 sx**

ELEVATION

PRODUCTION **D. & A**

FIGURES INDICATE BOTTOM OF FORMATIONS

- 453' Surface Sand & Clay
- 815' Red Bed, Shale & Gyp
- 1057' Red Bed & Gyp
- 1475' Red Bed, Gyp & Shale
- 1485' Anhydrite
- 1790' Red Bed
- 2190' Red Bed & Shale
- 2265' Shale & Shells
- 2535' Shale & Lime
- 2670' Shale
- 4010' Lime & Shale
- 4060' Lime
- 4190' Lime & Shale
- 4248' Lime
- 4438' Lime & Shale
- 4520' Lime
- 4630' Lime, Shale & Sand
- 5197' Lime & Shale
- 5335' Shale & Sand
- 5469' Lime, Sand & Shale
- 5469' RTD

RECEIVED
 STATE CORPORATION COMMISSION
 DEC 30 1968
 CONSERVATION DIVISION
 Wichita, Kansas

State of Kansas }
 County of Barton } SS

I, Eunice McEachern of Garvey Drilling Company

upon oath state the above and foregoing is a true and correct copy of the log of the Landrum No. 1 well.

Eunice McEachern

Subscribed and sworn to before me this 13th day of December 19 68

My Commission Expires: November 5th, 1969

Richard S. Doy
 NOTARY PUBLIC