

STATE OF KANSAS
STATE CORPORATION COMMISSION


Form CP-4

WELL PLUGGING RECORD

Give All Information Completely
Make Required Affidavit
Mail or Deliver Report to:
Conservation Division
State Corporation Commission
211 No. Broadway
Wichita, Kansas

Morton County, Sec. 13 Twp. 33S Rge. 42 (W)

Location as "NE/CNWxSWx" or footage from lines C SW NE
Lease Owner Cities Service Oil Company
Lease Name Minor "B" Well No. 1
Office Address Box 1228, Guymon, Oklahoma
Character of Well (completed as Oil, Gas or Dry Hole) Oil
Date well completed 11-26 19 66
Application for plugging filed 12-8 19 69
Application for plugging approved 12-9 19 69
Plugging commenced 12-13 19 69
Plugging completed 12-17 19 69
Reason for abandonment of well or producing formation uneconomical to produce

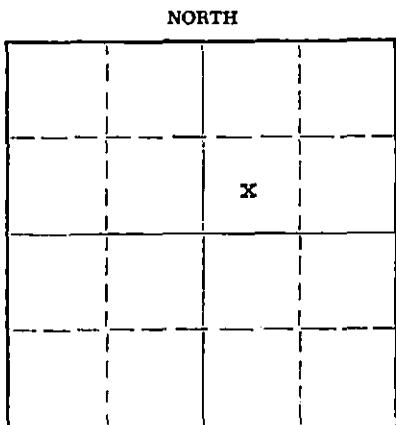

Locate well correctly on above Section Plat

If a producing well is abandoned, date of last production 8-2 19 69
Was permission obtained from the Conservation Division or its agents before plugging was commenced? Yes

Name of Conservation Agent who supervised plugging of this well Mr. E. Eves, Sublette, Kansas
Producing formation Morrow Depth to top 4989 Bottom 4992 Total Depth of Well 5127 Feet
Show depth and thickness of all water, oil and gas formations.

OIL, GAS OR WATER RECORDS

CASING RECORD

FORMATION	CONTENT	FROM	TO	SIZE	PUT IN	PULLED OUT
Morrow	Oil	4989	4992	8 5/8	1481' KB	None
				4 1/2	5155' KB	2530'

Describe in detail the manner in which the well was plugged, indicating where the mud fluid was placed and the method or methods used in introducing it into the hole. If cement or other plugs were used, state the character of same and depth placed, from _____ feet to _____ feet for each plug set.

Cement plugs were spotted as follows: 50 sx. pozmix cement from 4989' to 4332', mixed and circulated fresh mud from 1000' to G.L., 50 sx. cement from 700' to 550', 10 sx. from 25' to 4' at which point the 8 5/8" casing was cut off and steel cap welded on with date and well name.

RECEIVED
STATE CORPORATION COMMISSION
DEC 24 1969
CONSERVATION DIVISION
Wichita, Kansas

(If additional description is necessary, use BACK of this sheet)

Name of Plugging Contractor Daco Well Service
Address 1700 S. Main, Borger, Texas

STATE OF OKLAHOMA, COUNTY OF TEXAS, ss.
I, H. E. Massey (employee of owner) or (owner or operator) of the above-described

well, being first duly sworn on oath, says: That I have knowledge of the facts, statements, and matters herein contained and the log of the above-described well as filed and that the same are true and correct. So help me God.

H. E. Massey
(Signature) H. E. Massey
Dist. Manager
Box 1228, Guymon, Oklahoma 73942
(Address)

SUBSCRIBED AND SWORN TO before me this 22nd day of December, 1969

My commission expires 7-9-73

Melvin E. Dudley
Melvin E. Dudley Notary Public.

15-129-10299-0000

RECEIVED
STATE CORPORATION COMMISSION
DEC 9 1969
CONSERVATION DIVISION
Wichita, Kansas

Driller's Log
Minor "B" #1
Section 13-338-42W
Morton Co., Kansas

Sand & Shale	0 - 275
Sand, Shale & Gyp	275 - 990
Sand & Shale	990 - 1071
Sand	1071 - 1235
Shale	1235 - 1469
Anhydrite	1469 - 1490
Shale	1490 - 1530
Sand & Shale	1530 - 2260
Shale, Sand & Lime	2260 - 2520
Lime & Shale	2520 - 2845
Lime	2845 - 2951
Lime & Shale	2951 - 3469
Lime	3469 - 3717
Shale & Lime	3717 - 4052
Lime	4052 - 4242
Lime & Shale	4242 - 4512
Shale	4512 - 4720
Lime & Shale	4720 - 4870
Lime	4870 - 4880
Shale	4880 - 4967
Shale & Sand	4967 - 5002
Lime	5002 - 5060
Shale & Sand	5060 - 5290
Shale & Lime	5290 - 5332
Sand, Lime & Shale	5332 - 5378
Lime	5378 - 5588
Lime W/Chert	5588 - 5650
Lime	5650 - 5762
T.D.	5762