


STATE OF KANSAS
STATE CORPORATION COMMISSION

WELL PLUGGING RECORD

Give All Information Completely
Make Required Affidavit
Mail or Deliver Report to
Conservation Division
State Corporation Comm.
245 North Water
Wichita, KS 67202

Morton County, Sec. 27 Twp. 34S Rge. 40 X/W
Location as "NE/CNW/SW" or footage from lines
660' FN & WL

Lease Owner Anadarko Production Company
Lease Name BUDDRUS "A" Well No. 1
Office Address P. O. Box 351, Liberal, Kansas 67901
Character of Well (Completed as Oil, Gas or Dry Hole) DRY HOLE

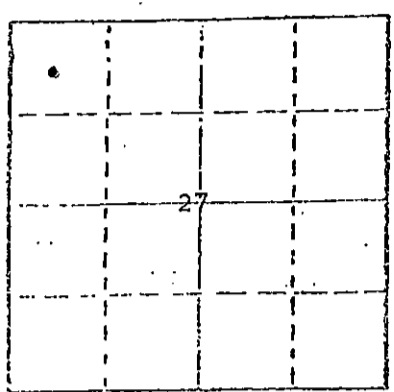

Locate well correctly on above Section Plot

Date Well completed January 23 1982
Application for plugging filed February 8 1982
Application for plugging approved verbal January 23 1982
Plugging commenced January 24 1982
Plugging completed January 24 1982
Reason for abandonment of well or producing formation DRY HOLE

If a producing well is abandoned, date of last production 19

Was permission obtained from the Conservation Division or its agents before plugging was commenced? yes

Name of Conservation Agent who supervised plugging of this well Paul Luthi
Producing formation _____ Depth to top _____ Bottom _____ Total Depth of Well 6621
Show depth and thickness of all water, oil and gas formations.

OIL, GAS OR WATER RECORDS

CASING RECORD

FORMATION	CONTENT	FROM	TO	SIZE	PUT IN	PULLED OUT
		1701	0	8-5/8"	1701	-0-

Describe in detail the manner in which the well was plugged, indicating where the mud fluid was placed and the method or methods used in introducing it into the hold. If cement or other plugs were used, state the character of same and depth placed, from _____ feet to _____ feet for each plug set.

Pushed rubber plug to 1680 w/40 sxs cmt, 35 sxs cmt at 800, 10 sxs from 40-0, 10 sxs in rathole, 5 sxs in mousehole, comp 7 am 1/24/82, pumped heavy drilling mud between plugs.

RECEIVED
STATE CORPORATION COMMISSION

FEB 23 1982

(If additional description is necessary, use BACK of this sheet)

Name of Plugging Contractor Wichita Albert-Jones, Inc.

STATE OF KANSAS COUNTY OF SEWARD, ss.
Paul Campbell (employee of owner) or (XXXXXXXXXXXXXXXXXX)

of the above-described well, being first duly sworn on oath, says: That I have knowledge of the facts, statements, and matters herein contained and the log of the above-described well as filed and that the same are true and correct. So help me God.

(Signature) Paul Campbell
P. O. Box 351, Liberal, Kansas 67901
(Address)

SUBSCRIBED AND SWORN TO before me this 2nd day of February, 1982

Beverly J. Williams
Notary Public.

My commission expires _____

STATE NOTARY PUBLIC
BEVERLY J. WILLIAMS
Seward County, Kansas
My Comm. Exp. 1982