

STATE OF KANSAS
STATE CORPORATION COMMISSION


WELL PLUGGING RECORD

Give All Information Completely
Make Required Affidavit
Mail or Deliver Report to:
Conservation Division
State Corporation Commission
211 No. Broadway
Wichita, Kansas

Summer County. Sec. 31 Twp. 34S Rge. (E) 1 (W)

Location as "NE/CNW/SW" or footage from lines NE-SE-NW
Lease Owner Sunray Mid-Continent Oil Company
Lease Name Ethel Quillin Well No. 1
Office Address Box # 788, Great Bend, Kansas
Character of Well (completed as Oil, Gas or Dry Hole) Dry Hole
Date well completed Nov. 8 19 58
Application for plugging filed Nov. 10 19 58
Application for plugging approved Nov. 12 19 58
Plugging commenced Nov. 8 19 58
Plugging completed Nov. 8 19 58
Reason for abandonment of well or producing formation

NORTH

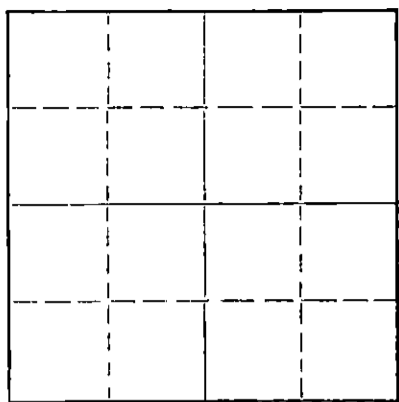

Locate well correctly on above
Section Plat

If a producing well is abandoned, date of last production 19
Was permission obtained from the Conservation Division or its agents before plugging was commenced? Yes

Name of Conservation Agent who supervised plugging of this well Hagar
Producing formation Depth to top Bottom Total Depth of Well 4695 Feet
Show depth and thickness of all water, oil and gas formations.

OIL, GAS OR WATER RECORDS

CASING RECORD

FORMATION	CONTENT	FROM	TO	SIZE	PUT IN	PULLED OUT
				8 5/8"	258'	None

Describe in detail the manner in which the well was plugged, indicating where the mud fluid was placed and the method or methods used in introducing it into the hole. If cement or other plugs were used, state the character of same and depth placed, from feet to feet for each plug set.

Filled hole w/mud to 200', 1/4 sack hulls & 15 sacks cement. Filled hole w/mud to 40' 1/4 sack hulls and 10 sacks cement. Cement to surface, plugging completed.

Log Attached.

RECEIVED
STATE CORPORATION COMMISSION
NOV 14 1958
CONSERVATION DIVISION
Wichita, Kansas

(If additional description is necessary, use BACK of this sheet)
Name of Plugging Contractor Halliburton Oil Well Cementing Company
Address

STATE OF KANSAS, COUNTY OF BARTON, ss.
N. E. Montgomery (employee of owner) or (owner) of the above-described well, being first duly sworn on oath, says: That I have knowledge of the facts, statements, and matters herein contained and the log of the above-described well as filed and that the same are true and correct. So help me God.

(Signature) N. E. Montgomery
Box # 788, Great Bend, Kansas
(Address)

SUBSCRIBED AND SWORN TO before me this 13th day of November, 19 58

My commission expires Dec. 24, 1960 Notary Public.

PLUGGING
FILE SEC 31 T. 34 R. 1W
BOOK PAGE 144 LINE 34

15-191-00717-0000

Sunray Mid-Continent Oil Company
Tulsa, Oklahoma

Tulsa, Oklahoma
November 10, 1958

CONTRACTOR: Stickle Drilling Company
Drilling Commenced: October 20, 1958
Drilling Completed: November 8, 1958

Ethel Quillin #1 S/2 SW/4
Sec. 30 & NW/4 Sec. 31-34S-
1W., Sumner Co., Kansas.

DRILLERS LOG

Depth Figures Indicate Base of Formation:

Surface	0
Shale & Shells	1095
Lime & Shale	1635
Shale & Lime	1740
Sand	1785
Lime & Shale	1845
Lime Shale & Sand	2005
Lime & Shale	3040
Sand & Shale	3135
Sand	3140
Shale & Lime	3235
Lime & Shale	3310
Lime Shale & Sand	3440
Sand	3550
Shale	3621
Lime	3630
Lime & Shale	3970
Shale & Lime	4080
Lime & Shale	4218
Lime	4288
Lime & Chert	4339
Lime	4371
Lime & Chert	4397
Lime	4487
Lime & Shale	4521
Shale - Dolomite	4550
Lime	4580
Lime & Shale	4658
Sand	4672
Hard Sand	4674
Sand	4695 TD

RECEIVED
STATE CORPORATION COMMISSION

I, Frank E. Stickle hereby certify the above to be a true and complete Driller's Log of Sunray Mid-Continent Oil Company Ethel Quillin #1 S/2 SW/4 Section 30 and NW/4 Section 31-34S-1W, Sumner County, Kansas.

Frank E. Stickle
Frank E. Stickle

Lillian T. Bonham
Notary Public

February 13, 1960
My Commission Expires

PLUGGING
FILE SEC 31 T 34 R 10
BOOK PAGE 144 LINE 34