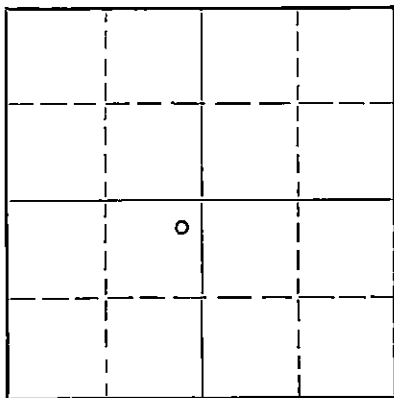


STATE OF KANSAS
STATE CORPORATION COMMISSION

Give All Information Completely
Make Required Affidavit
Mail or Deliver Report to:
Conservation Division
State Corporation Commission
800 Bittling Building
Wichita, Kansas

WELL PLUGGING RECORD

NORTH

Locate well correctly on above
Section Plat

Sumner

County. Sec. 2 Twp. 34S Rge. 2 (W)

Location as "NE/CNW/SW" or footage from lines NE NE SW

Lease Owner Thomas N. Berry & Company

Lease Name Mason

Well No. 1

Office Address P. O. Box 111, Stillwater, Oklahoma

Character of Well (completed as Oil, Gas or Dry Hole) Dry Hole

Date well completed June 1, 1954 19

Application for plugging filed June 1, 1954 (verbal) 19

Application for plugging approved June 1, 1954 (verbal) 19

Plugging commenced June 2, 1954 19

Plugging completed June 2, 1954 19

Reason for abandonment of well or producing formation Dry

If a producing well is abandoned, date of last production 19

Was permission obtained from the Conservation Division or its agents before plugging was commenced? Yes

Name of Conservation Agent who supervised plugging of this well W. G. Buffington

Producing formation Depth to top Bottom Total Depth of Well 4589 Feet

Show depth and thickness of all water, oil and gas formations.

OIL, GAS OR WATER RECORDS

CASING RECORD

FORMATION	CONTENT	FROM	TO	SIZE	PUT IN	PULLED OUT
				170	10-3/4"	None

Describe in detail the manner in which the well was plugged, indicating where the mud fluid was placed and the method or methods used in introducing it into the hole. If cement or other plugs were used, state the character of same and depth placed, from feet to feet for each plug set.

Filled hole full of heavy rotary mud
from 4589 feet to bottom of surface
pipe. Set bridge and plug with 15
sacks of cement. Mudded hole within
20 feet of top; set bridge and plug
with 10 sacks of cement. Welded
steel plate over top of surface pipe.

(If additional description is necessary, use BACK of this sheet)
Name of Plugging Contractor Bennett & Roberts Drilling Company
Address Russell, Kansas

STATE OF Oklahoma, COUNTY OF Payne, ss.
Jack D. Berry

(employee of owner) or (owner or operator) of the above-described well, being first duly sworn on oath, says: That I have knowledge of the facts, statements, and matters herein contained and the log of the above-described well as filed and that the same are true and correct. So help me God.

(Signature)


Jack D. Berry
Box 111, Stillwater, Okla.

(Address)

SUBSCRIBED AND SWORN TO before me this 8 day of June, 1954

My commission expires 1-24-56

24-7368-S 3-53-20M

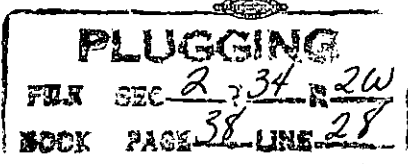

Notary Public.

15-191-00610-0000

Thos. N. Berry Co.
Glee Mason #1

NE NE SW Sec. 2-34-2
Sumner Co., Kansas

R.T.D. 4589

Conn: 4/19/54
Comp: 5/24/54

Casing
10 3/4" Set @ 170' w/
150 sx. cem.

Formation:	Depth:
Surface Hole	196
Shale & Shells	535
Shale & Shells	680
Shale & Lime Shells	1050
Lime w/shale & sand	1155
Shale	1320
Shale & Lime	1485
Sandy shale & Shells	1640
Shale	1820
Shale & Lime Shells	1965
Shale & Shells	2065
Lime	2085
Shale	2205
Shale & Shells	2305
Lime & Shale	2385
Shale	2530
Lime & Shale	2604
Shale	2676
Shale & Lime	2760
Shale	2935
Lime	2941
Brown lime & shale	2985
Sand odor	3001
Sand	3015
Sand & Sandy shale	3078
Shale & Shells	3106
Shale	3380
Sandy shale	3393
Shale	3410
Sand	3428
Lime	3542
Brown lime & shale	3595
Broken shales	3655
Sand	3664
Shale	3688
Lime	3729
Broken Lime	3782
Broken Shale	3827
Shale & Lime	4015
Shale	4048
Lime	4060
Miss Chat	4066
Miss. Lime	4104
Lime	4120
Miss. Lime	4138
Lime	4150
Miss. Lime	4168
Lime	4266
Lime Hard	4275
Lime	4308
Sandy shale	4334
Sand lime	4353
Shale	4370
Lime	4388
Shale	4485
Dolo.	4490
Lime	4499
Lime & sand	4509
Sand & shale Broken	4561
Lime & sand	4585

PLUGGING

FILE SEC 2 T 34 R 2W
BOOK PAGE 38 LINE 28

RECEIVED
STATE CORPORATION COMMISSION
JUN 9 - 1954
CONSERVATION DIVISION
Wichita, Kansas

Glee Mason #1

STATE OF KANSAS }
RUSSELL COUNTY } SS.

I hereby certify that the above information is true and correct
to the best of my knowledge.

Lorita Bond

Subscribed and sworn to before me this 2nd day of June, 1934.

Lillian A. Saluses
Notary Public

My commission expires 11/28/36