


STATE OF KANSAS
STATE CORPORATION COMMISSION

Give All Information Completely
Make Required Affidavit
Mail or Deliver Report to:
Conservation Division
State Corporation Commission
800 Bitting Building
Wichita, Kansas

WELL PLUGGING RECORD

NORTH

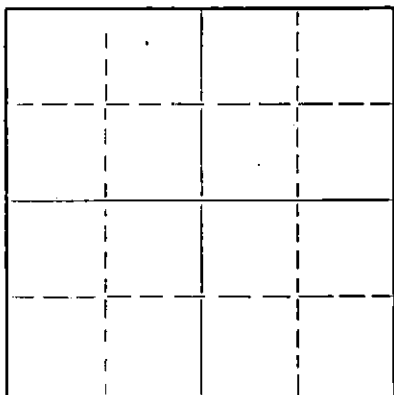

Locate well correctly on above
Section Plat

Sumner

County. Sec. 5 Twp. 34S Rge. XXEX 2 (W)

Location as "NE/CNW/SW" or footage from lines SW SW SE
Lease Owner Alpine Oil & Royalty Co., Inc.
Lease Name Roy Well No. 1
Office Address 1100 Bitting Bldg., Wichita, Kansas
Character of Well (completed as Oil, Gas or Dry Hole) Dry Hole
Date well completed June 24th, 1953
Application for plugging filed June 26th, 1953
Application for plugging approved June 26th, 1953
Plugging commenced June 26th, 1953
Plugging completed June 26th, 1953
Reason for abandonment of well or producing formation not productive

If a producing well is abandoned, date of last production 19____
Was permission obtained from the Conservation Division or its agents before plugging was commenced? Yes

Name of Conservation Agent who supervised plugging of this well W. G. Buffington
Producing formation _____ Depth to top _____ Bottom _____ Total Depth of Well 4578 Feet
Show depth and thickness of all water, oil and gas formations.

OIL, GAS OR WATER RECORDS

CASING RECORD

FORMATION	CONTENT	FROM	TO	SIZE	PUT IN	PULLED OUT
				8 5/8"	512'	cemented

Describe in detail the manner in which the well was plugged, indicating where the mud fluid was placed and the method or methods used in introducing it into the hole. If cement or other plugs were used, state the character of same and depth placed, from _____ feet to _____ feet for each plug set.

Heavy mud from Total Depth to 490'.
Solid at 490', and 15 sacks cement on same.
Heavy mud from cement to 40'. Another
plug and 10 sacks cement, then
welded cap on 8 5/8".

Name of Plugging Contractor QUAKER DRILLING CO., INC.
Address 1100 Bitting Bldg., Wichita, Kansas

STATE OF KANSAS COUNTY OF SEDGWICK, ss.

Thomas M. McCaul (owner or operator) of the above-described well, being first duly sworn on oath, says: That I have knowledge of the facts, statements, and matters herein contained and the log of the above-described well as filed and that the same are true and correct. So help me God.


(Signature)

(Address)

SUBSCRIBED AND SWORN TO before me this 26th day of June, 1953

Notary Public

My commission expires Sept. 14, 1953

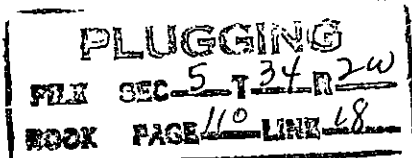

WELL LOG

ALPINE OIL & ROYALTY CO., INC.

Commenced: 5-20-53

Contractor: Quaker Drilling Co., Inc.

Completed: 6-24-53

Roy No. 1
SW SW SE Sec. 5-34S-2W
Sumner County, Kansas

Elevation: 1132 R.B.

Production: D & A

Casing Record:

Set 512' of 8 5/8" with
275 sacks cement

(Figures Indicate Bottom of Formations)

<u>FORMATION</u>	<u>DEPTH</u>	<u>FORMATION TOPS</u>
Sand & Shale	90	Topeka 2229
Shale & Shells	500	Stalnaker 2980
Lime	705	Layton 3350
Shale & Lime	870	Kansas City 3405
Lime	1005	Mississippi 4070
Shale & Lime	1215	Chatanooga 4443
Lime	1320	Misner 4500
Lime & Shale	2280	Viola 4503½
Lime	2370	Simpson 4522
Lime & Shale	3535	
Lime	3600	Total Depth (R) 4578
Lime & Shale	4079	
Chert	4112	
Lime & Chert	4143	
Chert	4146	
Lime & Chert	4325	
Lime, Chert, Shale	4347	
Shale	4371	
Lime & Chert	4438	
Lime, Chert, Shale	4448	
Lime & Shale	4521	
Sand	4528	
Sand & Shale	4578	

I hereby certify that the above is a true and correct copy of Drillers Log of well drilled in the SW SW SE of Section 5, Township 34 South, Range 2 West, Sumner County, Kansas.

ALPINE OIL & ROYALTY CO., INC.

By: Thomas M. M. Paul

SUBscribed and sworn to before me this 26th day of June, 1953.

Yashti Bell
Notary Public
My commission expires:
Sept. 14, 1953