

15-191-00499-0000

STATE OF KANSAS  
STATE CORPORATION COMMISSION

Give All Information Completely  
Make Required Affidavit  
Mail or Deliver Report to:  
Conservation Division  
State Corporation Commission  
800 Biting Building  
Wichita, Kansas


WELL PLUGGING RECORD

OR

FORMATION PLUGGING RECORD

Strike out upper line  
when reporting plugging  
off formations.

NORTH

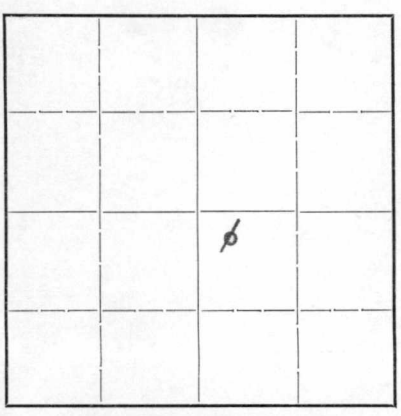

Locate well correctly on above  
Section Plat

Sumner County, Sec. 7 Twp. 34 Rge. (E) 2 (W)

Location as "NE 1/4 NW 1/4 SW 1/4" or footage from lines NW 1/4 NW 1/4 SE 1/4

Lease Owner The Akin Oil Company

Lease Name L. F. Stewart Well No. 1

Office Address 406 National Bank of Tulsa Building

Character of Well (completed as Oil, Gas or Dry Hole) Dry Hole

Date well completed Dec. 13 19 45

Application for plugging filed Dec. 29 19 45

Application for plugging approved Dec. 29 19 45

Plugging commenced Dec. 30 19 45

Plugging completed Dec. 31 19 45

Reason for abandonment of well or producing formation Dry hole

If a producing well is abandoned, date of last production none 19

Was permission obtained from the Conservation Division or its agents before plugging was commenced? Yes

Name of Conservation Agent who supervised plugging of this well W. G. Buffington

Producing formation none Depth to top -- Bottom -- Total Depth of Well 4576 Feet

Show depth and thickness of all water, oil and gas formations.

OIL, GAS OR WATER RECORDS


CASING RECORD

Formation	Content	From	To	Size	Put In	Pulled Out
Stalnaker Sand	Dry	3075	3163	10-3/4	135'	None
K. C. Lime	Dry	3435	3548			
Mississippi Lime	Dry	4118	4457			
Viola Lime	Dry	4525	4544			
Simpson Sand	Dry	4558	4576			

Describe in detail the manner in which the well was plugged, indicating where the mud fluid was placed and the method or methods used in introducing it into the hole. If cement or other plugs were used, state the character of same and depth placed, from \_\_\_\_\_ feet to \_\_\_\_\_ feet for each plug set.

Hole filled with rotary mud to bottom of surface casing. 15 sacks of cement placed from 125' to 85' and 10 sacks of cement 0' to 20'. Steel plate welded on top of 10-3/4 casing.

PLUGGING  
FILE SEC-7 TWP-34 RGE-2  
BOOK PAGE 39 LINE 2

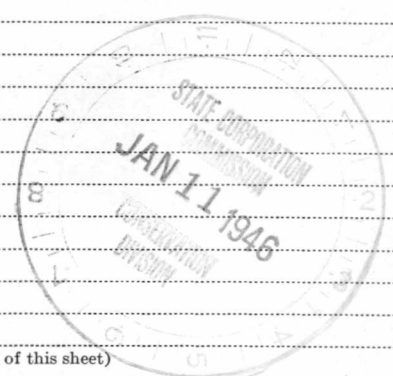

(If additional description is necessary, use BACK of this sheet)

Correspondence regarding this well should be addressed to Akin Oil Company

Address 406 National Bank of Tulsa Building, Tulsa, Oklahoma

STATE OF \_\_\_\_\_, COUNTY OF \_\_\_\_\_, SS.

\_\_\_\_\_ (employee of owner) or (owner or operator) of the above-described well, being first duly sworn on oath, says: That I have knowledge of the facts, statements, and matters herein contained and the log of the above-described well as filed and that the same are true and correct. So help me God.

(Signature) John Lawry Gen Supt  
406 Nat Bank of Tulsa Bldg Tulsa Okla  
(Address)

SUBSCRIBED AND SWORN to before me this 8th day of January, 1946

My commission expires February 7, 1948

J. J. Rhoads  
Notary Public.

AKIN OIL COMPANY

Stewart #1  
NW NW SE 7-34S-2W  
Sumner County, Kansas

0	-	140	Sand & shale
140	-	168	Sandy shale
168	-	498	Shale & lime shells broken
498	-	588	Shale & lime shells
588	-	709	Grey Shale
709	-	915	Lime & Shale
915	-	985	Shale & Shells
985	-	1080	Shale & lime
1080	-	1147	Shale & Lime hard
1147	-	1270	Lime shale breaks
1270	-	1317	Shale
1317	-	1324	Lime hard
1324	-	1333	Shale
1333	-	1340	Lime hard
1340	-	1562	Lime & shale
1562	-	1583	Sand
1583	-	1653	Shale
1653	-	1860	Shale & lime shells
1860	-	1876	Sand & shale
1876	-	1912	Shale
1912	-	1934	Lime
1934	-	1977	Shale
1977	-	2029	Limey shale
2029	-	2056	Sandy lime
2056	-	2235	Shale & shells
2235	-	2256	Sandy shale
2256	-	2310	Shale & lime
2310	-	2315	Shale
2315	-	2355	Lime
2355	-	2491	Shale & shells
2491	-	2543	Lime broken
2543	-	2563	Shale
2563	-	2620	Lime
2620	-	2654	Shale & lime shells
2654	-	2833	Shale
2833	-	2874	Lime
2874	-	3075	Shale
3075	-	3163	Stalnaker sand
3163	-	3418	Shale
3418	-	3435	Chert & shale
3435	-	3548	Kansas City Lime
3548	-	3555	Sand
3555	-	3565	Lime
3565	-	3580	Shale & Sand
3580	-	3586	Sand
3586	-	3740	Shale & lime
3740	-	3778	Sand & lime
3778	-	4118	Lime & shale
4118	-	4457	Mississippi lime
4457	-	4525	Shale
4525	-	4544	Viola lime
4544	-	4558	Dolomite
4558	-	4576	Sand T.D.

7 34 2W  
39 2

