
15-191-01565-0000

STATE OF KANSAS
STATE CORPORATION COMMISSION

Give All Information Completely
Make Required Affidavit
Mail or Deliver Report to:
Conservation Division
State Corporation Commission
800 Bitting Building
Wichita, Kansas

WELL PLUGGING RECORD

NORTH

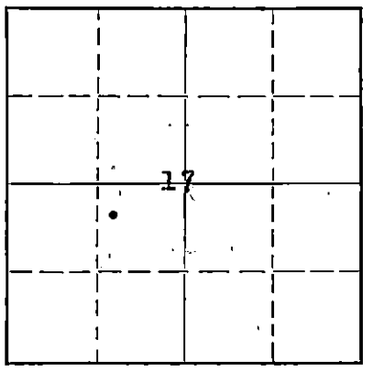

Locate well correctly on above Section Plat

Sumner County. Sec. 17 Twp. 34 Rge. 2 (E) W (W)
Location as "NE/CNW¼SW¼" or footage from lines NW NE SW
Lease Owner Vaughn E. Wiggins
Lease Name Edmondson Well No. 1
Office Address P.O. Box 191, McPherson Kansas
Character of Well (completed as Oil, Gas or Dry Hole) Dry Hole
Date well completed June 14 1963
Application for plugging filed June 14 1963
Application for plugging approved June 14 1963
Plugging commenced June 14 1963
Plugging completed June 14 1963
Reason for abandonment of well or producing formation
Non-Productive
If a producing well is abandoned, date of last production None 19
Was permission obtained from the Conservation Division or its agents before plugging was commenced? Yes

Name of Conservation Agent who supervised plugging of this well H. E. Hess
Producing formation Simpson Depth to top 4584 Bottom 4596 Total Depth of Well 4596 Feet
Show depth and thickness of all water, oil and gas formations.

OIL, GAS OR WATER RECORDS — CASING RECORD

Formation	Content	From	To	Size	Put In	Pulled Out
				8 5/8"	200'	None

Describe in detail the manner in which the well was plugged, indicating where the mud fluid was placed and the method or methods used in introducing it into the hole. If cement or other plugs were used, state the character of same and depth placed, from feet to feet for each plug set.

Hole filled with heavy mud to 240 ft
Set bridge w/ 1/4 sack hulls at 240'
Set 20 sack cement plug from 240' to 130'

Filled hole with heavy mud to 30'
Set 10 sack cement plug from 30' to bottom of cellar.

Plugged rat hole with 2 sacks cement

RECEIVED
STATE CORPORATION COMMISSION
JUN 27 1963
CONSERVATION DIVISION
Wichita, Kansas

(If additional description is necessary, use BACK of this sheet)

Correspondence regarding this well should be addressed to V. E. Wiggins
Address P.O. box 191, McPherson Kansas

STATE OF ~~McPherson~~ Kansas, COUNTY OF McPherson, ss.
Vaughn E. Wiggins (employee of owner) or (owner or operator) of the above-described well, being first duly sworn on oath, says: That I have knowledge of the facts, statements, and matters herein contained and the log of the above-described well as filed and that the same are true and correct. So help me God.

(Signature) Vaughn E. Wiggins

McPherson Kans.
(Address)

SUBSCRIBED AND SWORN TO before me this 26th day of June, 19 63

Notary Public.

My commission expires June 19 - 1965

22-7377-s 4-49—10M

15-191-01565-0000

Operator: V. E. Wiggins
Spudded: 5- 28- 63
Comp. : 6- 14- 63

W E L L L O G

Edmondson # 1
NW NE SW 17-34S-2W
Sumner County, Kansas

From	To	
0	30	Surface Sand
30	200	Blue Shale & Sand
200	755	Shale
755	1350	Lime & Shale
1350	1540	Shale & Lime
1540	1790	Lime & Shale
1790	1935	Shale & Lime Shells
1935	2380	Shale & Lime
2380	2540	Lime & Shale
2540	2624	Shale
2624	2629	Heebner
2629	2648	Shale
2648	2775	Shale & Lime
2775	2908	Lime & Shale
2908	3000	Shale
3000	3282	Lime & Shale
3282	3375	Lime
3375	3425	Lime & Shale
3425	3488	Lime
3488	3631	Lime & Shale
3631	3690	Lime
3690	3725	Shale
3725	3788	Lime
3788	3858	Lime & Shale
3858	3900	Lime
3900	4139	Shale & Lime
4139	4180	Mississippi
4180	4197	Chert Lime
4197	4234	Mississippi Chat
4234	4242	Chert Lime
4242	4307	Mississippi Chat
4307	4342	Chert Lime
4342	4373	Mississippi Chat
4373	4450	Lime
4450	4483	Chert Lime
4483	4492	Lime
4492	4517	Shale
4517	4550	Lime Shale
4550	4581	Lime
4581	4596	Shale Sand
4596		Total Depth

Elevation 1109 K.B.

Formation Tops:

Layton SS	3446
Kansas City	3456
Base Kansas City	3519
Cleveland	3526
Marmaton	3726
Cherokee	3870
Mississippi	4130
Kinderhook	4506
Viola	4566
Simpson	4584

RECEIVED
STATE CORPORATION COMMISSION
JUN 27 1963
CONSERVATION DIVISION
Wichita, Kansas

STATE OF KANSAS

COUNTY OF BARTON ss

T. D. Sweetman, Partner of S & S Drilling Company, Being first duly sworn on oath says: That I have knowledge of the facts, statements and matters herein contained and the log of the above described well as filed and that the same are true and correct.

T. D. Sweetman

Subscribed and sworn before me this 18 day of June, 1963.

Richard A. Crumm
Notary Public Barton County

My Commission Expires 4-27-62.