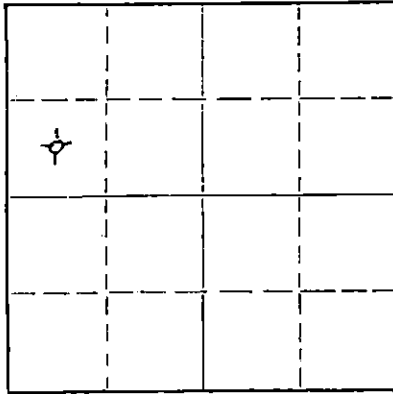


STATE OF KANSAS
STATE CORPORATION COMMISSION

Give All Information Completely
Make Required Affidavit
Mail or Deliver Report to:
Conservation Division
State Corporation Commission
211 No. Broadway
Wichita, Kansas

WELL PLUGGING RECORD

NORTH

Locate well correctly on above
Section Plat

Sumner

County. Sec. 8 Twp. 34S Rge. (E) 2W (W)

Location as "NE/CNW/SW" or footage from lines Cen. SW $\frac{1}{4}$ NW $\frac{1}{4}$

Lease Owner Schermerhorn Oil Corporation

Lease Name Stewart Trust

Well No. 1

Office Address 1870 South Boulder, Tulsa, Oklahoma

Character of Well (completed as Oil, Gas or Dry Hole) Dry Hole

Date well completed May 22, 1964

Application for plugging filed (verbally approved) May 25, 1964

Application for plugging approved (verbally approved) May 25, 1964

Plugging commenced May 22, 1964

Plugging completed May 22, 1964

Reason for abandonment of well or producing formation

If a producing well is abandoned, date of last production 19

Was permission obtained from the Conservation Division or its agents before plugging was commenced? Yes

Name of Conservation Agent who supervised plugging of this well Paul Turpin

Producing formation Depth to top Bottom Total Depth of Well 4552 Feet

Show depth and thickness of all water, oil and gas formations.

OIL, GAS OR WATER RECORDS

CASING RECORD

FORMATION	CONTENT	FROM	TO	SIZE	PUT IN	PULLED OUT
		0	242'	8-5/8"	242'	None

Describe in detail the manner in which the well was plugged, indicating where the mud fluid was placed and the method or methods used in introducing it into the hole. If cement or other plugs were used, state the character of same and depth placed, from feet to feet for each plug set.

Mudded the hole with 44 vis. mud to 220 feet. Set a dry hole plug, added 1/4 sack hulls and 15 sacks cement. Mudded hole from this point to 35 feet. Set a dry hole plug, added hulls and 8 sacks cement. Capped rat hole with 2 sacks cement.

RECEIVED
STATE CORPORATION COMMISSION

MAY 26 1964

CONSERVATION DIVISION
Wichita, Kansas

(If additional description is necessary, use BACK of this sheet)

Name of Plugging Contractor Birmingham-Bartlett Drilling Co.

Address (given above)

STATE OF KANSAS

COUNTY OF SEDGWICK

Richard Hindery, partner of Birmingham-Bartlett Drilling Co., drilling contractor, (employee or owner) or (owner or operator) of the above-described well, being first duly sworn on oath, says: That I have knowledge of the facts, statements, and matters herein contained and the log of the above-described well as filed and that the same are true and correct. So help me God. BIRMINGHAM-BARTLETT DRILLING CO.

(Signature)

By Richard Hindery

300 Kaufman Bldg., Wichita, Kansas
Partner
(Address)

SUBSCRIBED AND SWORN to before me this 25th day of May, 1964

Vivian F. Yinger
Notary Public.

My commission expires November 29, 1966.

R

STEWART TRUST NO. 1 WELL

LOCATION: Can. SW 1/4 NW 1/4 Sec. 8-34S-2W
Sumner County, Kansas

OPERATOR: Schermerhorn Oil Corporation
1870 South Boulder
Tulsa, Oklahoma

CONTRACTOR: Birmingham-Bartlett Drilling Co.
300 Kaufman Building
Wichita, Kansas

SURFACE CASING: 8-5/8" 20# casing cemented at
242' with 170 sacks cement.

OIL STRING: None Set. Dry Hole.
Plugged 5-22-64

SPUDDED: 5-8-64

COMPLETED: 5-22-64

L.O.G.

(Figures indicate bottom of formation)

0 -	40	Surface Clay and Sand
	242	Shale and Shells
	493	Shale
	525	Anhydrite
	1037	Shale and Shells
	1175	Shale
	1625	Shale and Lime
	1855	Shale with Lime Streaks
	3035	Shale and Lime
	3123	Shale and Sand
	3230	Shale and Lime
	3365	Shale
	3665	Shale and Lime
	3743	Lime
	4140	Shale and Lime
	4238	Lime and Chert
	4280	Shale and Lime
	4314	Lime, Shale and Chert
	4329	Lime and Chert
	4393	Lime
	4419	Shale and Lime
	4490	Lime
	4505	Shale and Lime
	4512	Lime
	4552	Simpson
	4552	Rotary Total Depth

RECEIVED
STATE CORPORATION COMMISSION

MAY 26 1964

CONSERVATION DIVISION
Wichita, Kansas

The undersigned, Richard Hindery, one of the partners of Birmingham-Bartlett Drilling Co., hereby certifies that the above is a true and correct log of the Stewart Trust No. 1 Well, as shown in the daily drilling reports.

BIRMINGHAM-BARTLETT DRILLING CO.

By

Richard Hindery, Partner

Subscribed and sworn to before
me this 25th day of May, 1964.

Vivian F. Yinger

Vivian F. Yinger, Notary Public
My commission expires November 29, 1966.