


STATE OF KANSAS  
STATE CORPORATION COMMISSION

WELL PLUGGING RECORD

Give All Information Completely  
Make Required Affidavit  
Mail or Deliver Report to:  
Conservation Division  
State Corporation Commission  
800 Bittling Building  
Wichita, Kansas

Stevens County. Sec. 14 Twp. 33S Rge. 36 (W)  
Location as "NE/CNW%SW%" or footage from lines C SE NW  
Lease Owner Shell Oil Company  
Lease Name A. & C. BROWN Area 18 Well No. 1-14  
Office Address P. O. Box 744, Great Bend, Kansas  
Character of Well (completed as Oil, Gas or Dry Hole) Dry Hole  
Date well completed September 12 19 59  
Application for plugging filed October 16 19 59  
Application for plugging approved (Verbal) September 12 19 59  
Plugging commenced September 12 19 59  
Plugging completed September 12 19 59  
Reason for abandonment of well or producing formation Dry Hole

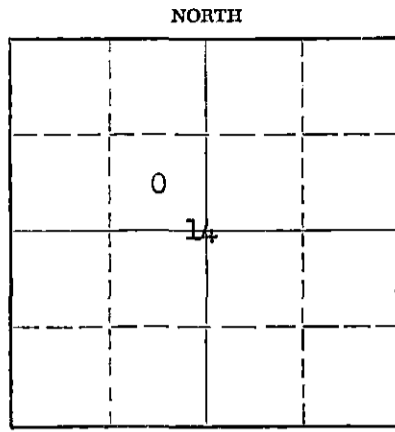

Locate well correctly on above Section Plat

If a producing well is abandoned, date of last production 19  
Was permission obtained from the Conservation Division or its agents before plugging was commenced? Yes

Name of Conservation Agent who supervised plugging of this well Merle A. Rives  
Producing formation Mississippian Depth to top 6080 Bottom - Total Depth of Well 6349 Feet  
Show depth and thickness of all water, oil and gas formations.

OIL, GAS OR WATER RECORDS

CASING RECORD

FORMATION	CONTENT	FROM	TO	SIZE	PUT IN	PULLED OUT
				8-5/8"	659'	None

Describe in detail the manner in which the well was plugged, indicating where the mud fluid was placed and the method or methods used in introducing it into the hole. If cement or other plugs were used, state the character of same and depth placed, from feet to feet for each plug set.

Pushed Howco 7-7/8" plug to 2838. Mixed & spotted 150 sax cement to 2550 by Halliburton. Pushed Howco 8-5/8" plug to 600 & capped with 25 sax cement to 530. Pushed 8-5/8" Howco plug to 35 & capped with 10 sax cement to 5' below ground level. Job completed at 10:30PM 9-12-59.

- 6349 - 2838 PB w/ mud
- 2838 - 2550 PB w/ cement
- 2550 - 600 PB w/ mud
- 600 - 530 PB w/ cement
- 530 - 35 PB w/ mud
- 35 - 0 PB w/ cement

RECEIVED  
STATE CORPORATION COMMISSION

OCT 19 1959

CONSERVATION DIVISION  
Wichita, Kansas

(If additional description is necessary, use BACK of this sheet)

Name of Plugging Contractor Company Rig No. 18 (with Halliburton)  
Address P. O. Box 744, Great Bend, Kansas

STATE OF KANSAS, COUNTY OF BARTON, ss.

A. W. Weber (employee of owner) of the above-described well, being first duly sworn on oath, says: That I have knowledge of the facts, statements, and matters herein contained and the log of the above-described well as filed and that the same are true and correct. So help me God.

(Signature) A. W. Weber

P. O. Box 744, Great Bend, Kansas (Address)

SUBSCRIBED AND SWORN TO before me this 16th day of October, 19 59

LaMont Byers, Jr. Notary Public.

My commission expires January 28, 1961

SHELL - A. & C. BROWN Area 18 No. 1-14  
C SE NW Section 14-33S-36W  
Wildcat (Hugoton)  
Stevens County, Kansas

Casing Record

8-5/8" cem 659 with 450 sax; cem circ.

- 0 - 668 surface & red beds
- 1940 shale
- 2363 shale w/ anhydrite
- 2506 shale w/ lime & anhydrite
- 2660 shale & anhydrite
- 2786 lime
- 2909 lime & shale
- 3064 lime
- 3173 lime w/ shale
- 3235 lime
- 3333 lime & shale
- 4591 lime
- 4603 lime & chert
- 4631 lime
- 4682 lime & chert
- 4725 lime & shale
- 4790 lime
- 4897 lime & shale
- 5083 shale w/ lime
- 5129 lime & shale
- 5168 lime
- 5331 lime & shale
- 5395 shale
- 5526 shale w/ lime
- 5674 shale
- 5762 lime & shale
- 5764 shale
- 6008 shale w/s lime
- 6060 sandstone, shaly,  
calcareous
- 6063 shale
- 6125 lime & shale
- 6206 shale w/s lime
- 6260 lime & shale
- 6349 lime T.D.

STATE OF KANSAS )  
                          ) SS  
COUNTY OF BARTON )

I hereby affirm that the above and fore-  
going is a true and correct copy of the  
drillers' log of the A. & C. Brown Area 18 No.  
1-14 well, located in Section 14-33S-36W,  
Stevens County, Kansas.

Shell Oil Company

By: A. W. Welser  
Superintendent

Subscribed and sworn to before me a Notary  
Public this 16th day of October, 1959.

Samuel Byers Jr.  
Notary Public

My commission expires: January 28, 1961.

- Log tops: Heebner 4121  
Toronto 4170  
Lansing-Kansas City 4275  
Marmaton 5027  
Morrow Shale 5744  
Mississippian:  
Chester 6080  
St. Genevieve 6281