


WELL PLUGGING RECORD

Give All Information Completely
Make Required Affidavit
Mail or Deliver Report to:
Conservation Division
State Corporation Commission
211 No. Broadway
Wichita, Kansas

Morton County. Sec. 9 Twp. 33 Rge. 41 (E) (W)
Location as "NE/CNW/SW" or footage from lines C NW SE
Lease Owner Anadarko Production Company
Lease Name Jones "B" Well No. 1
Office Address P. O. Box 351, Liberal, Kansas
Character of Well (completed as Oil, Gas or Dry Hole) Dry Hole
Date well completed April 29 1963
Application for plugging filed April 29 1963
Application for plugging approved April 29 1963
Plugging commenced April 29 1963
Plugging completed April 29 1963
Reason for abandonment of well or producing formation Dry

NORTH

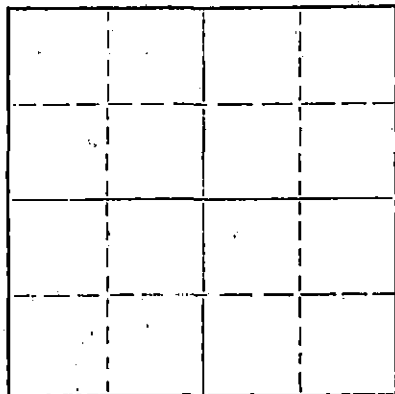

Locate well correctly on above Section Plat

If a producing well is abandoned, date of last production _____ 19____
Was permission obtained from the Conservation Division or its agents before plugging was commenced? Yes

Name of Conservation Agent who supervised plugging of this well Hugh. Scott
Producing formation _____ Depth to top _____ Bottom _____ Total Depth of Well 5440 Feet
Show depth and thickness of all water, oil and gas formations.

OIL, GAS OR WATER RECORDS

CASING RECORD

FORMATION	CONTENT	FROM	TO	SIZE	PUT IN	PULLED OUT
				8 5/8"	1513'	None

Describe in detail the manner in which the well was plugged, indicating where the mud fluid was placed and the method or methods used in introducing it into the hole. If cement or other plugs were used, state the character of same and depth placed, from _____ feet to _____ feet for each plug set.

Spotted 20 sacks at 5070'
Spotted 115 sacks at 3100'
Spotted 35 sacks at 700'
Spotted 15 sacks at 5'

RECEIVED
STATE CORPORATION COMMISSION

MAY 1 1963

CONSERVATION DIVISION
Wichita, Kansas

(If additional description is necessary, use BACK of this sheet)
Name of Plugging Contractor Holm Drilling Company
Address P. O. Box 7505, Southside Station, Tulsa 5, Oklahoma

STATE OF KANSAS, COUNTY OF SEWARD, ss.
S. H. Neithercoat (employee of owner) or ~~known proprietor~~ of the above-described well, being first duly sworn on oath, says: That I have knowledge of the facts, statements, and matters herein contained and the log of the above-described well as filed and that the same are true and correct. So help me God.

(Signature) S. H. Neithercoat
S. H. Neithercoat, Superintendent
P. O. Box 351, Liberal, Kansas
(Address)

SUBSCRIBED AND SWORN TO before me this 30th day of April, 1963

Donald L. Vaught
Notary Public.

