

15-129-00321-0000


Give All Information Completely
Make Required Affidavit
Mail or Deliver Report to:
Conservation Division
State Corporation Commission
212 No. Market
Wichita, Kansas

WELL PLUGGING RECORD

Morton County, Sec. 13 Twp. 33 Rgc. 41 (E) (W)

Location as "NE/CNW/SE/SW" or footage from lines NW SE
Lease Owner Pan Eastern Exploration Company
Lease Name Santa Fe Land Well No. 1
Office Address Box 828 - Liberal, Kansas 67901
Character of Well (completed as Oil, Gas or Dry Hole) Gas
Date well completed 5/27/1956
Application for plugging filed 9/07/1978
Application for plugging approved 9/14/1978
Plugging commenced 9/18/1978
Plugging completed 9/20/1978
Reason for abandonment of well or producing formation Zone flooded out due to hole in casing.
If a producing well is abandoned, date of last production 2/10/1978
Was permission obtained from the Conservation Division or its agents before plugging was commenced? Yes

NORTH

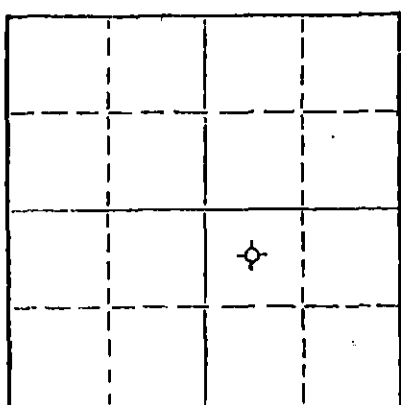

Locate well correctly on above
Section Plat

Name of Conservation Agent who supervised plugging of this well Clarence Thomas
Producing formation Hugoton Depth to top 2203 Bottom 2286 Total Depth of Well 2360 Feet
Show depth and thickness of all water, oil and gas formations.

OIL, GAS OR WATER RECORDS

CASING RECORD

FORMATION	CONTENT	FROM	TO	SIZE	PUT IN	PULLED OUT
Surface	Water	150	387	7	440	0
Hugoton	Gas	2203	2286	4 1/2	2354	1289

Describe in detail the manner in which the well was plugged, indicating where the mud fluid was placed and the method or methods used in introducing it into the hole. If cement or other plugs were used, state the character of same and depth placed, from feet to feet for each plug set.

Mixed 2 sacks hulls and 20 sacks cement to plug perfs. Plugged at 2175 feet. Shot 4 1/2 at 1388 feet and 1284 feet.
Pipe loose at 1284 feet. Spotted 35 sacks from 300'-400'.
Put 10 sacks cement from 0-40 feet. Cut off and capped casing.

RECEIVED
STATE CORPORATION COMMISSION

OCT 10 1978
10-10-78
CONSERVATION DIVISION
Wichita, Kansas

(If additional description is necessary, use BACK of this sheet)
Name of Plugging Contractor Sargent's Casing Pulling Service
Address Box 506 - Liberal, Kansas 67901


STATE OF Kansas, COUNTY OF Seward, ss.
Joe Krafft (employee of owner) or (owner or operator) of the above-described well, being first duly sworn on oath, says: That I have knowledge of the facts, statements, and matters herein contained and the log of the above-described well as filed and that the same are true and correct. So help me God.

(Signature) Joe Krafft
P. O. Box 828 - Liberal, Kansas 67901
(Address)

SUBSCRIBED AND SWORN to before me this 4th day of October, 1978

My commission expires 2-9-82

Jana L. Meinig
Notary Public.

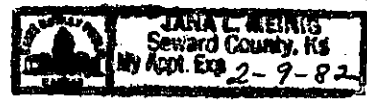

RECEIVED
STATE CORPORATION COMMISSION

SEP 18 1978

SANTA FE #1Well Record

Location: Section 13-338-41W
Morton County, Kansas

Operator: Panhandle Eastern Pipe Line Co.
1221 Baltimore
Kansas City, Missouri.

Contractor: Graham-Michaelis Drilling Co.
1005 East Second Street
Wichita 1, Kansas

Casing Records: 7" @ 439.88' w/250 sacks Pozmix Cement
4-1/2" @ 2354' w/100 sacks Pozmix Cement

CONSERVATION DIVISION

Wichita, Kansas
Commenced: May 13, 1956

Completed: May 17, 1956

LOG

Gravel, Clay & Hard Lime	439
Red Bed & Shale	500
Red Bed & Sand	970
Red Bed & Gyp.	1012
Anhydrite	1048
Red Bed	1210
Red Bed & Gyp.	1491
Shale	1512
Shale & Red Bed	1637
Shale, Shells & Red Bed	1955
Anhydrite & Shale	2254
Sandy Lime & Shale	2360, RTD

STATE OF KANSAS)
) ss.
COUNTY OF SEDGWICK)

The undersigned, GRAHAM-MICHAELIS DRILLING COMPANY, hereby certifies that the above log is a true and correct log of the formations encountered in drilling the above well as reflected by the Daily Drilling Report.

GRAHAM-MICHAELIS DRILLING CO.

By John L. James
John L. James
Geologist