

WELL PLUGGING RECORD

Information Completely  
Not Required Affidavit  
Mail or Deliver Report to:  
Conservation Division  
State Corporation Commission  
211 No. Broadway  
Wichita, Kansas

Morton County, Sec. 17 Twp. 33S Rge. 41W (E) (W)

Location as "NE/CNW/SW" or footage from lines. SE NW

Lease Owner Thomas & Brewer

Lease Name Murphy Well No. 1

Office Address Drawer 1177, Liberal, Kansas

Character of Well (completed as Oil, Gas or Dry Hole) Dry Hole

Date well completed 12-28 19 64

Application for plugging filed 12-31 19 63

Application for plugging approved 12-31 19 63


Plugging commenced 1-1 19 64

Plugging completed 1-3 19 64

Reason for abandonment of well or producing formation Dry hole

If a producing well is abandoned, date of last production 19

Was permission obtained from the Conservation Division or its agents before plugging was commenced? Yes

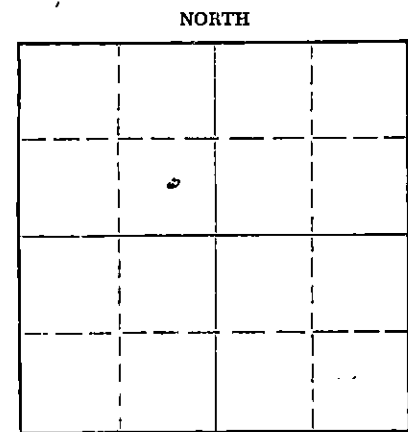

Locate well correctly on above  
Section Plat

Name of Conservation Agent who supervised plugging of this well Hugh Scott

Producing formation Upr. Morros Sand(Purdy) Depth to top 4990 Bottom 5014 Total Depth of Well 5398 Feet

Show depth and thickness of all water, oil and gas formations.

OIL, GAS OR WATER RECORDS

CASING RECORD

FORMATION	CONTENT	FROM	TO	SIZE	PUT IN	PULLED OUT
				8 5/8	1496	none
				4 1/2	5060	3011

Describe in detail the manner in which the well was plugged, indicating where the mud fluid was placed and the method or methods used in introducing it into the hole. If cement or other plugs were used, state the character of same and depth placed, from feet to feet for each plug set.

Mix 20 sacks cement to plug off perforations. Stop plug at 4900'. Mud to 700' & pump 35 sx. cement at 700' to 600'. Mud to 45 feet & 15 sacks of cement from 15' to 0. Cut 8 5/8 off 3' below ground level & weld metal cap on same.

RECEIVED  
STATE CORPORATION COMMISSION

JAN 16 1964

1-16-64

CONSERVATION DIVISION  
Wichita, Kansas

(If additional description is necessary, use BACK of this sheet)

Name of Plugging Contractor Sargent's Casing Pulling Service License No. 511

Address 121 W. 9th, Liberal, Kansas

STATE OF KANSAS, COUNTY OF SEWARD, ss.  
Delvin P. Luck (employee of owner) or (owner or operator) of the above-described well, being first duly sworn on oath, says: That I have knowledge of the facts, statements, and matters herein contained and the log of the above-described well as filed and that the same are true and correct. So help me God.

(Signature) Delvin P. Luck

Box 1177, Liberal, Kansas (Address)

SUBSCRIBED AND SWORN TO before me this 15th day of January, 19 64

Marlene Keating Notary Public

My commission expires 11-5-66

