


Give All Information Completely
Make Required Affidavit
Mail or Deliver Report to:
Conservation Division
State Corporation Commission
211 No. Broadway
Wichita, Kansas

WELL PLUGGING RECORD

Morton County, Sec. 17 Twp. 33S Rge. 41W (E) (W)

NORTH

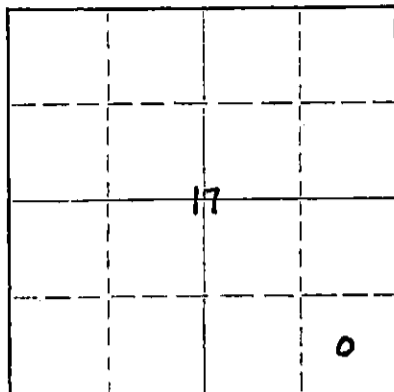

Locate well correctly on above Section Plat

Location as "NE/CNWxSWx" or footage from lines SE SE
Lease Owner Thomas & Brewer
Lease Name Neptune Well No. 3
Office Address Box 1177, Liberal, Kansas
Character of Well (completed as Oil, Gas or Dry Hole) Dry Hole
Date well completed 8-12-63
Application for plugging filed 11-5-63
Application for plugging approved 11-6-63
Plugging commenced 11-6-63
Plugging completed 11-7-63
Reason for abandonment of well or producing formation Dry

If a producing well is abandoned, date of last production _____
Was permission obtained from the Conservation Division or its agents before plugging was commenced? Yes

Name of Conservation Agent who supervised plugging of this well Hugh Scott
Producing formation _____ Depth to top _____ Bottom _____ Total Depth of Well _____ Feet
Show depth and thickness of all water, oil and gas formations.

OIL, GAS OR WATER RECORDS

CASING RECORD

FORMATION	CONTENT	FROM	TO	SIZE	PUT IN	PULLED OUT
Surface Sands	Fresh Water	40'	150'	8 5/8	1588	None
				4 1/2	5140	2900

Describe in detail the manner in which the well was plugged, indicating where the mud fluid was placed and the method or methods used in introducing it into the hole. If cement or other plugs were used, state the character of same and depth placed, from _____ feet to _____ feet for each plug set.

Mix 20 sks cement to plug off perforations at 5048. Stop plug at 4950 leaving cement at 4950 to 5140. Mud to 1650 and pump 150 sx. cement at 1650. Leaving cement 1650-1500. Well to be used later for salt water disposal

RECEIVED
STATE CORPORATION COMMISSION

NOV 18 1963

11-18-63
CONSERVATION DIVISION
Wichita, Kansas

RECEIVED
STATE CORPORATION COMMISSION

NOV 12 1963

CONSERVATION DIVISION
Wichita, Kansas

(If additional description is necessary, use BACK of this sheet)

Name of Plugging Contractor Sargents Casing Pulling Service
Address 121 W. 9th, Liberal, Kansas

STATE OF KANSAS, COUNTY OF SEWARD, ss.
Glenn F. Thomas (employee of owner) or (owner or operator) of the above-described well, being first duly sworn on oath, says: That I have knowledge of the facts, statements, and matters herein contained and the log of the above-described well as filed and that the same are true and correct. So help me God.

(Signature) [Signature]
Box 1177, Liberal, Kansas
(Address)

SUBSCRIBED AND SWORN TO before me this 8th day of November, 19 63

My commission expires 11-5-66

Marlene Keeling
Notary Public