


WELL PLUGGING RECORD

Give All Information Completely  
Make Required Affidavit  
Mail or Deliver Report to:  
Conservation Division  
State Corporation Commission  
211 No. Broadway  
Wichita, Kansas

Stevens County, Sec. 27 Twp. 33S Rge. 37 (E) W (W)

Location as "NE/CNW/SW" or footage from lines C-SW-SE  
Lease Owner Socony Mobil Oil Company, Inc.  
Lease Name Fred C. Anderson Well No. 1  
Office Address 300 North Broadway, Wichita, Kansas 67202  
Character of Well (completed as Oil, Gas or Dry Hole) Dry Hole  
Date well completed \_\_\_\_\_ 19\_\_\_\_  
Application for plugging filed \_\_\_\_\_ 7-30-1963  
Application for plugging approved \_\_\_\_\_ 7-29-1963  
Plugging commenced \_\_\_\_\_ 7-29-1963  
Plugging completed \_\_\_\_\_ 7-29-1963  
Reason for abandonment of well or producing formation Drilled Dry

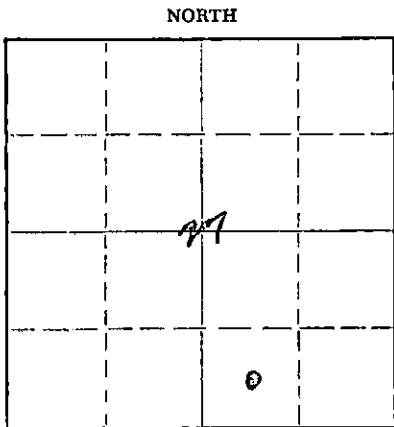

Locate well correctly on above Section Plat

If a producing well is abandoned, date of last production \_\_\_\_\_ 19\_\_\_\_  
Was permission obtained from the Conservation Division or its agents before plugging was commenced? Yes

Name of Conservation Agent who supervised plugging of this well Hugh Scott  
Producing formation \_\_\_\_\_ Depth to top \_\_\_\_\_ Bottom \_\_\_\_\_ Total Depth of Well 6625' Feet  
Show depth and thickness of all water, oil and gas formations.

OIL, GAS OR WATER RECORDS

CASING RECORD

FORMATION	CONTENT	FROM	TO	SIZE	PUT IN	PULLED OUT
				8 5/8"	1660'	None

Describe in detail the manner in which the well was plugged, indicating where the mud fluid was placed and the method or methods used in introducing it into the hole. If cement or other plugs were used, state the character of same and depth placed, from \_\_\_\_\_ feet to \_\_\_\_\_ feet for each plug set.

Cemented at 6610' w/50 Sk. regular cement + 10% gel. 2950' w/100 Sk. reg. cement + 10% gel. 300' w/25 sks. reg. cement + 10% gel., 40' w/10 sk. reg. cement + 10% gel.

RECEIVED  
STATE CORPORATION COMMISSION

AUG 1 1963

CONSERVATION DIVISION  
Wichita, Kansas

(If additional description is necessary, use BACK of this sheet)

Name of Plugging Contractor Graham Michaelis Drlg. Co.  
Address 211 North Broadway - Wichita, Kansas

STATE OF Kansas, COUNTY OF Sedgwick, ss.  
L. L. Davis (employee of owner) or (owner or operator) of the above-described well, being first duly sworn on oath, says: That I have knowledge of the facts, statements, and matters herein contained and the log of the above-described well as filed and that the same are true and correct. So help me God.

(Signature) L. L. Davis  
300 North Broadway - Wichita, Kansas 67202  
(Address)

SUBSCRIBED AND SWORN TO before me this 31st day of July, 19 63

My commission expires 4-4-66

Jack Bearden  
Notary Public.

INVOICED

DATE 8/1/63  
INV. NO. 2508-U

FRED C. ANDERSON #1

WELL RECORD:

LOCATION:

C SW SE Section 27-33S-37W  
Stevens County, Kansas

Commenced: 7-13-63  
Completed: 7-28-63  
(Rotary)

CONTRACTOR:

Graham-Michaelis Drilling Co.  
Liberal Division  
P. O. Box 1294  
Liberal, Kansas

CASING RECORD:

54 Joints 8-5/8" 24# Casing  
Cemented w/500 sx 50/50 Pozmix  
8% Gel 2% cc followed w/100 sx  
Common 2% cc


LOG

Surface Sand & Clay	0 - 275
Red Bed	275 - 590
Red Bed, Gyp & Sand	590 - 1102
Gyp, Sand & Red Bed	1102 - 1660
Red Bed & Stone Corral	1660 - 1690
Red Bed	1690 - 2370
Shale & Lime	2370 - 3315
Lime	3315 - 3463
Lime & Shale	3463 - 4294
Lime	4294 - 5383
Lime & Shale	5383 - 6422
Lime	6422 - 6625

6625' - Total Rotary Depth

The undersigned, Graham-Michaelis Drilling Company, Liberal Division, certifies that the above log is a true and correct copy of the formations encountered in drilling the above mentioned well, as taken from the Daily Drilling Report.

GRAHAM-MICHAELIS DRILLING COMPANY  
LIBERAL DIVISION

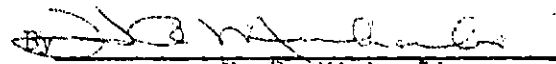  
H. R. Michaelis

**RECEIVED**  
STATE CORPORATION COMMISSION

NOV 21 1963

CONSERVATION DIVISION  
Wichita, Kansas