

STATE OF KANSAS
STATE CORPORATION COMMISSION

Form CP-4

WELL PLUGGING RECORD

Give All Information Completely
Make Required Affidavit
Mail or Deliver Report to:
Conservation Division
State Corporation Commission
212 No. Market
Wichita, Kansas

Stevens County, Sec. 35 Twp. 33S Rgs. 37W (E) (W)

Location as "NE/CNWxSWx" or footage from lines C-SE-SE

Lease Owner Blaik Oil Company

Lease Name Harrison Well No. 1

Office Address 203 Park Avenue, Oklahoma City, Oklahoma 73102

Character of Well (completed as Oil, Gas or Dry Hole) D & A

Date well completed October 29, 1968

Application for plugging filed October 28, 1968

Application for plugging approved October 28, 1968


Plugging commenced October 28, 1968

Plugging completed 3:30 A.M., October 29, 1968

Reason for abandonment of well or producing formation D & A

If a producing well is abandoned, date of last production 19

Was permission obtained from the Conservation Division or its agents before plugging was commenced? Yes

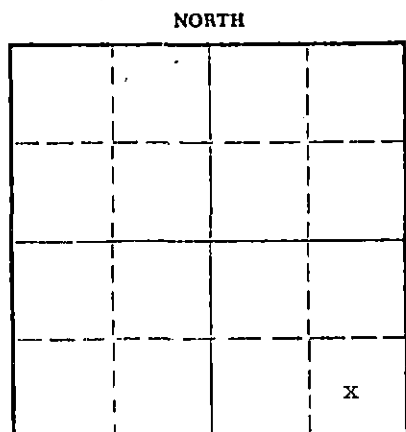

Locate well correctly on above Section Plat

Name of Conservation Agent who supervised plugging of this well

Producing formation Depth to top Bottom Total Depth of Well 6709 Feet

Show depth and thickness of all water, oil and gas formations.

OIL, GAS OR WATER RECORDS

CASING RECORD

FORMATION	CONTENT	FROM	TO	SIZE	PUT IN	PULLED OUT
				8 5/8"	1732.53	

Describe in detail the manner in which the well was plugged, indicating where the mud fluid was placed and the method or methods used in introducing it into the hole. If cement or other plugs were used, state the character of same and depth placed, from feet to feet for each plug set.

900' - 35 sx.

Top - 15 sx.

RECEIVED
STATE CORPORATION COMMISSION
NOV 6 1968
CONSERVATION DIVISION
Wichita, Kansas

(If additional description is necessary, use BACK of this sheet)

Name of Plugging Contractor Zenith Drilling Corporation, Inc.

Address Suite 737 - 300 West Douglas, Wichita, Kansas 67202

STATE OF KANSAS, COUNTY OF SEDGWICK, ss.

C. Robert Buford (employee of owner) of the above-described

well, being first duly sworn on oath, says: That I have knowledge of the facts, statements, and matters herein contained and the log of the above-described well as filed and that the same are true and correct. So help me God.

(Signature) C. Robert Buford

Suite 737 - 300 W. Douglas, Wichita, Kansas (Address)

SUBSCRIBED AND SWORN to before me this 4th day of November, 1968.

Myrna D. Murphy Notary Public.

My commission expires August 15, 1971.

WELL LOG

COMPANY BLAIK OIL COMPANY

SEC. 35-33S-37W

FARM HARRISON NO. 1

LOC. SE-SE

TOTAL DEPTH 6709'


COUNTY Stevens

COMM. October 14, 1968 COMP. October 29, 1968

CONTRACTOR Zenith Drilling Corp., Inc.

CASING

8 5/8" @1723' w/750 sx.

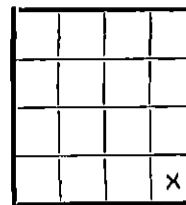

ELEVATION

PRODUCTION D & A

FIGURES INDICATE BOTYOM OF FORMATIONS

715'	Sand, Red Bed
1575'	Red Bed, Sand, Gyp
1724'	Red Bed & Anhydrite
1902'	Anhydrite & Red Bed
2310'	Red Bed, Shale
2670'	Shale
2900'	Shale, Lime
3020'	Lime
3134'	Lime, Shale
4020'	Shale, Lime
4136'	Lime, Shale
4255'	Lime
4510'	Lime, Shale
4605'	Lime
4766'	Lime, Shale
5350'	Lime
5510'	Lime, Shale
5835'	Shale, Lime
6195'	Shale
6252'	Shale, Lime
6709' D.T.D.	Lime

RECEIVED
STATE CORPORATION COMMISSION
NOV 6 1968
CONSERVATION DIVISION
Wichita, Kansas

State of Kansas }
County of Sedgwick } ss

I, C. Robert Buford, President of Zenith Drilling Corporation, Inc.
upon oath state the above and foregoing is a true and correct copy of the log of the Harrison #1 well.

C. Robert Buford

Subscribed and sworn to before me this 4th day of November, 1968.

My Commission Expires: Aug. 15, 1971.

Maymas S. Murphy
NOTARY PUBLIC