

STATE OF KANSAS  
STATE CORPORATION COMMISSION

WELL PLUGGING RECORD

Give All Information Completely  
Make Required Affidavit  
Mail or Deliver Report to:  
Conservation Division  
State Corporation Commission  
212 No. Market  
Wichita, Kansas

Stevens

County, Sec. 3 Twp. 33S Rge. 37 (E) X (W)

Location as "NE/CNW/SW" or footage from lines 1250' NSL, 2500' EWL

Lease Owner Mobil Oil Corporation

Lease Name Hill #1 Unit

Well No. 2

Office Address P. O. Box 1934, Oklahoma City, Oklahoma 73101

Character of Well (completed as Oil, Gas or Dry Hole) Dry Hole

Date well completed P & A 2-22- 1973

Application for plugging filed 19  

Application for plugging approved 19  

Plugging commenced 2-22 1973


Plugging completed 2-22 1973

Reason for abandonment of well or producing formation

No sand development

If a producing well is abandoned, date of last production 19  

Was permission obtained from the Conservation Division or its agents before plugging was commenced?   

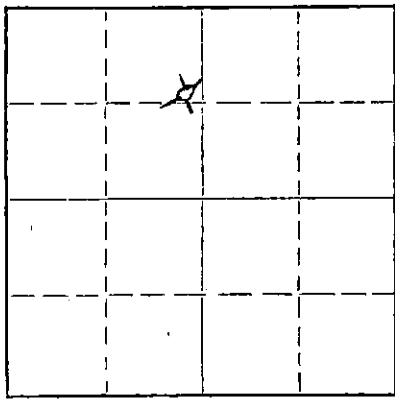

Locate well correctly on above Section Plat

Name of Conservation Agent who supervised plugging of this well Ed Eaves

Producing formation None Depth to top    Bottom    Total Depth of Well 6300 Feet

Show depth and thickness of all water, oil and gas formations.

OIL, GAS OR WATER RECORDS

CASING RECORD

FORMATION	CONTENT	FROM	TO	SIZE	PUT IN	PULLED OUT
None				8-5/8"	1761'	None

Describe in detail the manner in which the well was plugged, indicating where the mud fluid was placed and the method or methods used in introducing it into the hole. If cement or other plugs were used, state the character of same and depth placed, from    feet to    feet for each plug set.

Set a 35 sack cement plug at 1700' and a 25 sack cement plug from 60' to surface.  
Casing cut 3' below ground level and capped with steel plate.

Witnessed and approved by Ed Eaves, representative of Kansas Corporation Commission.

RECEIVED  
STATE CORPORATION COMMISSION  
MAR 5 1973

CONSERVATION DIVISION  
Wichita, Kansas

RECEIVED  
STATE CORPORATION COMMISSION  
FEB 28 1973

CONSERVATION DIVISION  
Wichita, Kansas

(If additional description is necessary, use BACK of this sheet)  
Name of Plugging Contractor Zenith Drilling Company  
Address 200 West Douglas, Suite 600, Wichita, Kansas 67202

STATE OF OKLAHOMA, COUNTY OF Oklahoma, ss.  
Paul K. Langenberg (employee of owner) or ~~XXXXXX~~ of the above-described well, being first duly sworn on oath, says: That I have knowledge of the facts, statements, and matters herein contained and the log of the above-described well as filed and that the same are true and correct. So help me God.

(Signature) Paul K. Langenberg  
Paul K. Langenberg  
Box 1934, Oklahoma City, Oklahoma 73101

SUBSCRIBED AND SWORN to before me this 26th day of February, 1973

My commission expires November 17, 1973

Richard N. Squibb  
Notary Public.

**KANSAS DRILLERS LOG**

S. 3 T. 33 R. 37 E  
W

API No. 15 — Stevens — 189  
County Number

Loc. C N/2

County Stevens

Operator  
**Mobil Oil Corporation**

Address  
**P. O. Box 1934, Oklahoma City, Oklahoma 73101**


Well No. 2 Lease Name Hill #1 Unit

Footage Location  
1250 feet from (N) (S) line 2500 feet from (E) (W) line

Principal Contractor Zenith Drilling Company Geologist Roger Wilkinson

Spud Date 2-8-73 Total Depth 6300' P.B.T.D.

Date Completed P&A 2-22-73 Oil Purchaser

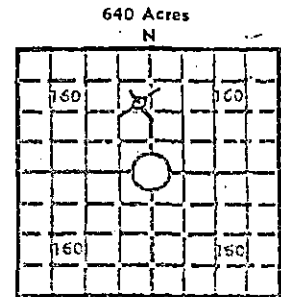

Locate well correctly  
Elev.: Gr. 3113'

DF. KB

**CASING RECORD**

Report of all strings set — surface, intermediate, production, etc.

Purpose of string	Size hole drilled	Size casing set (in O.D.)	Weight lbs/ft.	Setting depth	Type cement	Sacks	Type and percent additives
Surface	12 1/4"	8-5/8"	23#	1761'	Comm	500	12% Gel 3% CG

**RECEIVED**  
 STATE CORPORATION COMMISSION  
 MAR 6 1973  
 CONSERVATION DIVISION  
 Wichita, Kansas

**LINER RECORD**

**PERFORATION RECORD**

Top, ft.	Bottom, ft.	Shots per ft.	Size & type	Depth interval
		None		

**TUBING RECORD**

Size	Setting depth	Packer set at

**ACID, FRACTURE, SHOT, CEMENT SQUEEZE RECORD**

Amount and kind of material used	Depth interval treated
None	

**INITIAL PRODUCTION**

Date of first production	Producing method (flowing, pumping, gas lift, etc.) <b>Dry Hole</b>
RATE OF PRODUCTION PER 24 HOURS	Oil bbls. Gas MCF Water bbls. Gas-oil ratio CFPB
Disposition of gas (vented, used on lease or sold)	Producing interval(s)

INSTRUCTIONS: As provided in KCC Rule 82-2-125, within 90 days after completion of a well, one completed copy of this Drillers Log shall be transmitted to the State Geological Survey of Kansas, 4150 Monroe Street, Wichita, Kansas 67209. Copies of this form are available from the Conservation Division, State Corporation Commission, 3830 So. Meridian (P.O. Box 17027), Wichita, Kansas 66217. Phone AC 316-522-2206. If confidential custody is desired, please note Rule 82-2-125. Drillers Logs will be on an open file in the Oil and Gas Division, State Geological Survey of Kansas, Lawrence, Kansas 66044.

15-189-20170-0000

DESIGNATE TYPE OF COMP.: OIL, GAS, DRY HOLE, SWDW, ETC.:

Operator Mobil Oil Corporation	
Well No. 2	Lease Name Hill #1 Unit
Dry Hole	
S <u>3</u> T <u>33</u> R <u>37</u> E W	

**WELL LOG**

Show all important zones of porosity and contents thereof; cored intervals, and all drill-stem tests, including depth interval tested, cushion used, time tool open, flowing and shut-in pressures, and recoveries.

SHOW GEOLOGICAL MARKERS, LOGS RUN, OR OTHER DESCRIPTIVE INFORMATION.

FORMATION DESCRIPTION, CONTENTS, ETC.	TOP	BOTTOM	NAME	DEPTH
Sand	40	180	Herrington	2554
Red Bed, Sand	180	1345	U. Krider	2584
Red Bed	1345	1725	L. Krider	2610
Anhy., Red Bed	1725	2200	Winfield	2666
Anhy., Shale	2200	2400	Towanda	2724
Shale, Lime	2400	2700	Ft. Riley	2780
Lime, Shale	2700	3225	Wreford	2868
Lime	3225	5530	Council Grove	2892
Shale, Lime	5530	6300	Admire	3140
			Wabaunsee	3318
Total Depth	6300		Heebner	4142
			Toronto	4170
			Lansing	4220
			Marmaton	4952
			Cherokee	5150
			Morrow	5683
			Chester	6113

RECEIVED  
STATE CORPORATION COMMISSION  
MAR 6 1973  
CONSERVATION DIVISION  
Wichita, Kansas

USE ADDITIONAL SHEETS, IF NECESSARY, TO COMPLETE WELL RECORD.

Date Received	<p><i>Paul K. Langenberg</i> Paul K. Langenberg Signature Office Group Supervisor Title February 26, 1973 Date</p>
---------------	--