


### WELL PLUGGING RECORD

Give All Information Completely  
Make Required Affidavit  
Mail or Deliver Report to:  
Conservation Division  
State Corporation Commission  
211 No. Broadway  
Wichita, Kansas

Seward County, Sec. 13 Twp. 34 Rge. (E) 32 (W)

Location as "NE/CNW/SW" or footage from lines G SE NW  
Lease Owner Anadarko Production Company  
Lease Name Davies "B" Well No. 1  
Office Address Box 351, Liberal, Kansas  
Character of Well (completed as Oil, Gas or Dry Hole) Dry Hole  
Date well completed November 7, 1961 19 61  
Application for plugging filed November 7, 1961 19 61  
Application for plugging approved Verbally by Mr. LacKamp 11-7 19 61  
Plugging commenced November 7 19 61  
Plugging completed November 7 19 61  
Reason for abandonment of well or producing formation Dry Hole

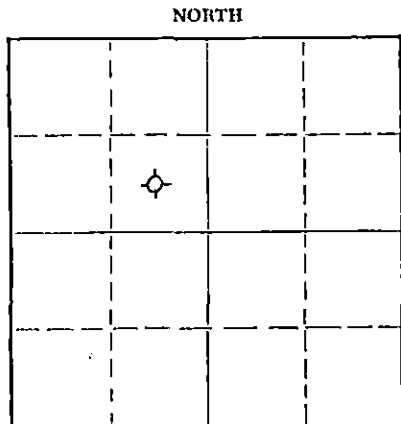

Locate well correctly on above Section Plat

If a producing well is abandoned, date of last production 19  
Was permission obtained from the Conservation Division or its agents before plugging was commenced? Yes

Name of Conservation Agent who supervised plugging of this well Mr. LacKamp  
Producing formation \_\_\_\_\_ Depth to top \_\_\_\_\_ Bottom \_\_\_\_\_ Total Depth of Well 6612 Feet  
Show depth and thickness of all water, oil and gas formations. PBTD 4676

#### OIL, GAS OR WATER RECORDS

#### CASING RECORD

FORMATION	CONTENT	FROM	TO	SIZE	PUT IN	PULLED OUT
				8 5/8	2617'	--
				4 1/2	4704'	2665'

Describe in detail the manner in which the well was plugged, indicating where the mud fluid was placed and the method or methods used in introducing it into the hole. If cement or other plugs were used, state the character of same and depth placed, from \_\_\_\_\_ feet to \_\_\_\_\_ feet for each plug set.

Spotted rock bridge at 650' and capped with 20 sacks cement. Mudded from 650' to 30'.  
Set rock bridge at 30' and capped with 10 sacks cement from 30' to surface.

RECEIVED  
STATE CORPORATION COMMISSION

NOV 17 1961  
11-17-61  
CONSERVATION DIVISION

(If additional description is necessary, use BACK of this sheet)

Name of Plugging Contractor Andrews Well Servicing Company  
Address 402 East Park, Liberal, Kansas

STATE OF Kansas, COUNTY OF Seward, ss.  
R. L. O'Shields (employee of owner) or (owner or operator) of the above-described well, being first duly sworn on oath, says: That I have knowledge of the facts, statements, and matters herein contained and the log of the above-described well as filed and that the same are true and correct. So help me God.

(Signature) R. L. O'Shields  
Manager, Drilling and Production  
P. O. Box 351, Liberal, Kansas  
(Address)

SUBSCRIBED AND SWORN TO before me this 16th day of November, 19 61

My commission expires MY COMMISSION EXPIRES SEPT. 29, 1964

Ronald L. VanFleet Notary Public.

*R*

DRILLER'S LOG

WELL NAME Davies "B" No. 1 COMPANY OPERATING Anadarko Production Company  
 ADDRESS of COMPANY Box 351, Liberal, Kansas  
 WELL LOCATION C 1/4 SE 1/4 NW 1/4,  
ft. North of South line,  
ft. East of West line; Sec. 13 Twp. 34 Rge. 32, Seward County, Kansas  
 DRILLING STARTED September 30, 1961 . DRILLING COMPLETED October 28, 1961  
 WELL COMPLETED November 7, 1961 WELL CONNECTED \_\_\_\_\_, 19\_\_\_\_  
 ELEVATION 2751 KB ft. Ground Level CHARACTER OF WELL (Oil, Gas, or Dry Hole) Dry Hole

OIL OR GAS SANDS OR ZONES - PERFORATIONS - ACIDIZING AND FRACTURING INFORMATION					
Name	From	To	No. of Shots	Gallons Used	Kind Used
Lansing	4551	4553	8	1750	7 1/2%
Shawnee	4145	4149	16	500	

RECEIVED  
 STATE CORPORATION COMMISSION  
 NOV 17 1961  
 CONSERVATION DIVISION  
 Wichita, Kansas

CASING RECORD

Size	Amount Set	Sacks of Cement	Amount Pulled
8 5/8	2625	1150	---
4 1/2	4704	250	2665

FORMATION RECORD

Formation	Top	Bottom	Formation	Top	Bottom
Surface Hole	0	2616	Lime & Shale	4260	4355
Sand	2616	2770	Lime	4355	4455
Sand & Lime	2770	2895	Lime & Shale	4455	4555
Lime & Shale	2895	3155	Lime	4555	5400
Lime & Chalk	3155	3300	Lime & Chert	5400	5455
Lime & Chert	3300	3380	Lime & Shale	5455	5499
Lime & Chalk	3380	3530	Lime	5499	5724
Lime	3530	3585	Lime & Shale	5724	6336
Lime & Chalk	3585	3720	Lime	6336	6488
Lime	3720	3870	Lime & Shale	6488	6532
Lime & Shale	3870	4080	Lime	6532	6588
Shale	4080	4260	Lime & Chert	6588	6591
			Lime	6591	6610
			Total Depth	6610	

RESULTS of INITIAL PRODUCTION TEST: Dry and Abandoned