


Give All Information Completely  
Make Required Affidavit  
Mail or Deliver Report to:  
Conservation Division  
State Corporation Commission  
211 No. Broadway  
Wichita, Kansas

WELL PLUGGING RECORD

NORTH

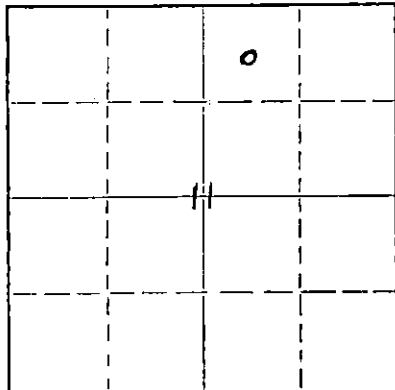

Locate well correctly on above  
Section Plat

Seward County, Sec. 11 Twp. 34S Rge. 3 (E) 32 (W)  
Location as "NE/CNW/SW" or footage from lines. CNW NE  
Lease Owner Beren Corporation  
Lease Name Marcellus #1- Well No. 1-11  
Office Address 970 Fourth Financial Center  
Character of Well (completed as Oil, Gas or Dry Hole) Dry Hole  
Date well completed 1/17 1976  
Application for plugging filed 3/1/76 1976  
Application for plugging approved 1/17 1976  
Plugging commenced 1/17 1976  
Plugging completed 1/17 1976  
Reason for abandonment of well or producing formation Dry Hole

If a producing well is abandoned, date of last production -0- 19    
Was permission obtained from the Conservation Division or its agents before plugging was commenced? Yes

Name of Conservation Agent who supervised plugging of this well Clarence Thomas, Garden City, Kansas  
Producing formation None Depth to top    Bottom    Total Depth of Well    Feet  
Show depth and thickness of all water, oil and gas formations.

OIL, GAS OR WATER RECORDS

CASING RECORD

| FORMATION | CONTENT | FROM | TO    | SIZE  | PUT IN | PULLED OUT |
|-----------|---------|------|-------|-------|--------|------------|
|           | 8 5/8   | 0    | 1559' | 8 5/8 |        | None       |
|           |         |      |       |       |        |            |
|           |         |      |       |       |        |            |
Describe in detail the manner in which the well was plugged, indicating where the mud fluid was placed and the method or methods used in introducing it into the hole. If cement or other plugs were used, state the character of same and depth placed, from    feet to    feet for each plug set.

50 sx. cement @ 1500'  
15 sx. @ 40' to 3"  
5 sx. Mousehole  
5 sx. Rathole Completed @ 1:45 pm - 1/17/76

MAR 15 1976  
3-15-76  
STATE OF KANSAS  
WICHITA


(If additional description is necessary, use BACK of this sheet)  
Name of Plugging Contractor Plugged w/Rotary Drilling Co. - Rine Drilling Company  
Address Suite 600, 300 West Douglas, Wichita, Kansas 67202

STATE OF KANSAS, COUNTY OF SEDGWICK, ss.  
Jim Thatcher (employee of owner) or (owner or operator) of the above-described

well, being first duly sworn on oath, says: That I have knowledge of the facts, statements, and matters herein contained and the log of the above-described well as filed and that the same are true and correct. So help me God.

(Signature) JIM THATCHER  
970 4th. Financial Center, Wichita, Ks. 67202  
(Address)

SUBSCRIBED AND SWORN to before me this 12th day of March, 1976  
Catherine A. Carr  
Catherine A. Carr Notary Public.  
My commission expires January 31, 1977

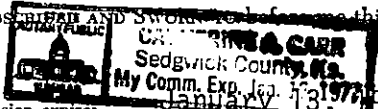

15-175-20280-0000

NW ~~NW~~ NE  
SECTION 11-34-32N  
SEWARD COUNTY, KANSAS

MARCELLUS #1-11

CONTRACTOR: RINE DRILLING COMPANY

STARTED: DECEMBER 31, 1975

COMPLETED: JANUARY 17, 1976

J O B

|                          |       |   |       |
|--------------------------|-------|---|-------|
| Surface                  | 0'    | - | 61'   |
| Red Bed, Sand & Shale    | 61'   | - | 787'  |
| Sand, Anhydrite & Gypsum | 787'  | - | 1492' |
|                          |       |   |       |
| Anhydrite & Sand         | 1492' | - | 1565' |
| Anhydrite, Sand & Shale  | 1565' | - | 1640' |
| Anhydrite                | 1640' | - | 1657' |
| Shale, Sand & Anhydrite  | 1657' | - | 2187' |
| Anhydrite & Shale        | 2187' | - | 2410' |
| Red Bed & Anhydrite      | 2410' | - | 2528' |
| Shale, Lime & Sand       | 2528' | - | 2787' |
| Anhydrite & Shale        | 2787' | - | 2728' |
| Lime & Shale             | 2728' | - | 5847' |
|                          |       |   |       |
| Shale & Sand             | 5847' | - | 5875' |
| Lime & Shale             | 5875' | - | 6040' |

Totco - 1/4° @ 556'

Totco - 1/2° @ 1108'. Ran 39 jts.  
8 5/8" csg. set @ 1559'. Cmt. w/725  
sx. lite, 2% cc. 100 sx. common,  
3% cc

Totco - 1/4° @ 1565'

Totco - 1/2° @ 2145'

Totco - 1° @ 2528'

Totco - 1° @ 3043'; 1° @ 3648'; 3/4°  
@ 4180'; 3/4° @ 5034'; 1° @ 5230'

Totco - 3/4° @ 5875'

Plugged & Abandoned through open end  
drillpipe as follows:

- 50 sx. @ 1500'
- 15 sx. @ 40' to 3'
- 5 sx. in Rathole
- 5 sx. in Mousehole

Job completed @ 1:45 pm - 1/17/76  
Kansas State Plugger: Clarence Thomas  
Garden City, Kansas

RECEIVED  
STATE CONSERVATION COMMISSION  
MAR 15 1976  
CONSERVATION DIVISION  
Wichita, Kansas

STATE OF KANSAS )  
COUNTY OF SEDGWICK) ss

I, E. J. Rine, do hereby certify that the above is a true and accurate log of the Marcellus#1-11 located NW of NW of Section 11-34-32N, Seward County, Kansas.

\_\_\_\_\_  
E. J. Rine, President

Subscribed and sworn to before me this 29th day of January, 1976.

\_\_\_\_\_  
Carol J. Hladik, Notary Public

My commission expires: 10/31/79