

15-175-20091-00010  
JC

RECEIVED  
STATE CORPORATION COMMISSION


1-15-75  
CONSERVATION DIVISION  
Wichita, Kansas

Form CP-4

STATE OF KANSAS  
STATE CORPORATION COMMISSION

Give All Information Completely  
Make Required Affidavit  
Mail or Deliver Report to:  
Conservation Division  
State Corporation Commission  
P. O. Box 17027  
Wichita, Kansas 67217  
NORTH

WELL PLUGGING RECORD

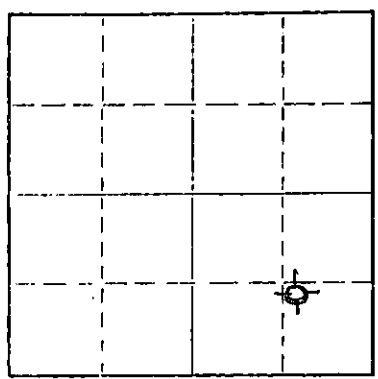

Locate well correctly on above  
Section Flat

Location as "NE/CNW&SW" or footage from lines 1250' fr. E/L 1050' Fr. N/L  
Lease Owner Petrodynamics, Inc.  
Lease Name Johnson Well No. 1  
Office Address Amarillo, Texas  
Character of Well (completed as Oil, Gas or Dry Hole) \_\_\_\_\_  
Date well completed Jan. 14 19 70  
Application for plugging filed \_\_\_\_\_ 19 \_\_\_\_\_  
Application for plugging approved \_\_\_\_\_ 19 \_\_\_\_\_  
Plugging commenced May 2 19 74  
Plugging completed May 6 19 74  
Reason for abandonment of well or producing formation \_\_\_\_\_  
If a producing well is abandoned, date of last production \_\_\_\_\_ 19 \_\_\_\_\_  
Was permission obtained from the Conservation Division or its agents before plugging was commenced? Yes

Name of Conservation Agent who supervised plugging of this well Ed Eves  
Producing formation \_\_\_\_\_ Depth to top \_\_\_\_\_ Bottom \_\_\_\_\_ Total Depth of Well 6500  
Show depth and thickness of all water, oil and gas formations.

OIL, GAS OR WATER RECORDS

CASING RECORD

FORMATION	CONTENT	FROM	TO	SIZE	PUT IN	PULLED OUT
				8 5/8	1530	none
				4 1/2	6500	2720

Describe in detail the manner in which the well was plugged, indicating where the mud fluid was placed and the method or methods used in introducing it into the hole. If cement or other plugs were used, state the character of same and depth placed, from \_\_\_\_\_ feet to \_\_\_\_\_ feet for each plug set.

Pump 20 sks. of cement to 5700  
Pump 35 sks. of cement @ 900 to 800  
Put 15 sks. of cement @ 15 to 0

(If additional description is necessary, use BACK of this sheet)

Name of Plugging Contractor Sargents Casing Pulling Service Kansas No. 511  
Address Box 506 Liberal, Kansas 67901

STATE OF Texas COUNTY OF Pettus, ss.  
Joe C. Richardson, Jr. (employee of owner) or (owner or operator) of the above-described well, being first duly sworn on oath, says: That I have knowledge of the facts, statements and matters herein contained and the log of the above-described well as filed and that the same are true and correct. So help me God.

(Signature) Joe C. Richardson, Jr. - Agent  
Box 10006 Amarillo, Texas 79106  
(Address)

SUBSCRIBED AND SWORN TO before me this 13<sup>th</sup> day of January 19 75

My commission expires June 1, 1975  
Wendy Bergana  
RECEIVED Notary Public.

MAY 31 1974

PetroDynamics, Inc.  
Amarillo, Texas 79109

Drig. Contractor: Stickle Drilling Company Johnson No. 1  
Date Commenced: 15 December 1969 1250' FEL & 1050' FNL  
Date Completed: 30 December 1969 9-34S-32W Seward Co., Ks.

DRILLER'S LOG

Depth figures indicate base of formation:

Surface Soil and Clay	45
Sand	300
Sand and Red Bed	1335
Red Bed and Anhydrite	1530
Anhydrite and Red Bed	1600
Red Bed and Anhydrite	2085
Shale and Anhydrite	2640
Shale	2900
Lime	3820
Lime and Shale	3994
Lime	5750
Shale and Lime	5945
Lime and Shale	6360
Lime	6500 RTD

RECEIVED  
STATE CORPORATION COMMISSION  
APR 30 1974  
CONSERVATION DIVISION  
Wichita, Kansas

I, Clifford M. Smith, hereby certify that to the best of my knowledge and belief, the above is a true and complete Driller's Log of PetroDynamics, Inc. No. 1 Johnson in Seward County, Kansas.

*Clifford M. Smith*  
\_\_\_\_\_  
Clifford M. Smith

*Frederic E. Wicick*  
\_\_\_\_\_  
Frederic E. Wicick, Notary Public  
My Commission Expires 23 June 1970  
NOTARY PUBLIC  
BUTLER COUNTY, KANSAS